

\$ 4.00 REMONUMENTATION
 \$ 7.00 DEED
 23 DEC 96 10:26 A.M. RECEI
 RECORDED
 FOREST E. YOUNGBLOOD, REGISTER
 WAYNE COUNTY, MI

LAND CORNER RECORDATION CERTIFICATE
Filing Requirement of Act 74, Mich. P.A. 1970

For corners in

WAYNE

(County)


Located In:
 CITY OF DETROIT

Corner Code #

LIBER 29356 PAGE 103

- | | | |
|---------------------------------------|--------------------------|------------|
| 1. Public Land Survey | T <u>1S</u> R <u>11E</u> | <u>E-5</u> |
| | T _____ | _____ |
| | T _____ | _____ |
| | T _____ | _____ |
| 2. Property Controlling in Section | S _____ T _____ R _____ | _____ |
| | S _____ T _____ R _____ | _____ |
| 3. Miscellaneous Property in Sec. | S _____ T _____ R _____ | _____ |
| | S _____ T _____ R _____ | _____ |
| 4. Lot No. _____, Recorded Plat _____ | | |
| 5. Private Claims _____ | | |

Compliance with
 ACT 345, P.A. 1990
 APPROVED ON: DEC. 6, 1996
 WAYNE COUNTY REMONUMENTATION
 PEER GROUP COMMITTEE
 Register of Deeds Stamp & File Number

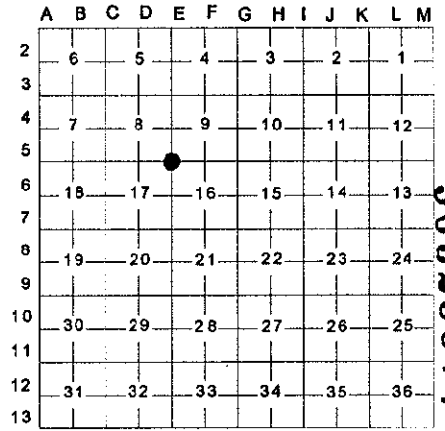

I, MARTIN C. DUNN, in a field survey on OCTOBER 10, 19 96, do hereby certify that under requirements of P.A. 74, Michigan P.A. of 1970, the corner points mentioned in lines 1 and 2 above were in conformance with regulations and rules therefore as required in the current manual of survey instructions of the United States Department of the Interior, Bureau of Land Management or by a decree of a Court of Law and/or that the corner points mentioned in lines 3, 4 and 5 above were in conformance with the rules of the Michigan Board of Land Surveyors or by a Decree of a Court of Law, established, re-established, monumented, re-monumented, recovered, found as expressed below:

NOTE: Not more than 2 corners, all in the same town and range, may be recorded on this certificate.

A. Description of original monument and accessories and/or subsequent restoration:

UNDER CONTRACT FOR THE GLO ORIGINAL SURVEY (DATED SEPT., 1816), JOSEPH FLETCHER SET A POST. NO EVIDENCE OF ORIGINAL CORNER FOUND.

PLATS

L. 35 P. 51	PALMER HOMES SUBDIVISION	7-8-1916
L. 40 P. 79	PALMER BOULEVARD SUBDIVISION	10-9-1919
L. 44 P. 56	AURORA PARK SUBDIVISION	8-22-1922

B. Description of corner evidence found and/or method applied in restoring or reestablishing corner:

RE-ESTABLISHED CORNER AT WYOMING (66' WD.) AND McNICHOLS (VARIABLE WIDTH (APHALT)) BY HOLDING FOUND MONUMENTS IN THE ABOVE LISTED "PALMER HOMES SUB'n". HELD THE FOUND MONUMENTS AT THE NORTHEAST CORNER OF GRIGGS AND THE NORTHWEST CORNER OF WYOMING ALONG McNICHOLS AND FOUND IRON PIPE ALONG WEST SIDE OF WYOMING.

VERIFIED LOCATION WITH OTHER FOUND IRONS AND MONUMENTS ALONG BOTH McNICHOLS AND WYOMING AND BY MEASURING UP THE ADJACENT BLOCKS USING WALK AND STREET SPLITS WITH REFERENCE TO THE ABOVE LISTED PLATS.



C. Description of monument for corner and accessories established to perpetuate locating the position of the corner:

E-5 SOUTHWEST CORNER SECTION 9 T.1S., R.11E.

PLACED BRASS WAYNE COUNTY REMONUMENTATION WASHER AND PLASTIC CAP #30081 ON 1/2" x 18" IRON REBAR WITHIN A NEW MONUMENT BOX.

WITNESSES

N.37°E. 48.80'	CITY OF DETROIT VERTICAL CONTROL MONUMENT.
S.43°E. 43.22'	SET P.K. NAIL WITH WAYNE COUNTY REMON TAG IN CONCRETE WALK
S.27°W. 56.35'	SET P.K. NAIL WITH WAYNE COUNTY REMON TAG IN CONCRETE WALK
N.36°W. 48.77'	SET P.K. NAIL WITH WAYNE COUNTY REMON TAG IN CONCRETE WALK

THE SELECTED LOCATION IS A CAREFUL AND FAITHFUL RE-ESTABLISHMENT OF THE POSITION OF THE ORIGINAL CORNER.

Signed by Martin C. Dunn Date 12-23-96
 Surveyor's Michigan License No. 30081

4R
 7D
 JBJ