

**SURVEY &  
REMONUMENTATION**

LIBER 28452 PAGE 756

**LAND CORNER RECORDATION CERTIFICATE**

APR 05 1996 Filing Requirement of Act 74, Mich. P.A. 1970

For corners in

**WAYNE**

(County)

**COMMISSION**

Located In:

**GREENFIELD TWP  
(NOW CITY OF DETROIT)**

Corner Code #

- |                                    |   |           |   |            |             |
|------------------------------------|---|-----------|---|------------|-------------|
| 1. Public Land Survey              | T | <u>1S</u> | R | <u>11E</u> | <u>E-12</u> |
|                                    | T |           | R |            |             |
|                                    | T |           | R |            |             |
|                                    | T |           | R |            |             |
| 2. Property Controlling in Section | S |           | T | R          |             |
|                                    | S |           | T | R          |             |
| 3. Miscellaneous Property in Sec.  | S |           | T | R          |             |
|                                    | S |           | T | R          |             |

Compliance with  
ACT 345, P.A. 1990

APPROVED ON: DEC 5 1995 *WCAO.*  
WAYNE COUNTY REMONUMENTATION  
PEER GROUP COMMITTEE

Register of Deeds Stamp & File Number

4. Lot No. \_\_\_\_\_, Recorded Plat \_\_\_\_\_  
5. Private Claims \_\_\_\_\_

	A	B	C	D	E	F	G	H	I	J	K	L	M
2	6	5	4	3	2	1							
3													
4	7	8	9	10	11	12							
6													
6	18	17	16	15	14	13							
7													
8	19	20	21	22	23	24							
9													
10	30	29	28	27	26	25							
11													
12	31	32	33	34	35	36							
13													

I, STEVEN E. DUNN, in a field survey on OCTOBER 8, 19 95, do hereby certify that under requirements of P.A. 74, Michigan P.A. of 1970, the corner points mentioned in lines 1 and 2 above were in conformance with regulations and rules therefore as required in the current manual of survey instructions of the United States Department of the Interior, Bureau of Land Management or by a decree of a Court of Law and /or that the corner points mentioned in lines 3, 4 and 5 above were in conformance with the rules of the Michigan Board of Land Surveyors or by a Decree of a Court of Law; established, re-established, monumented, re-monumented, recovered, found as expressed below:

**NOTE: Not more than 4 corners, all in the same town and range, may be recorded on this certificate.**


**A. Description of original monument and accessories and/or subsequent restoration:**

**GLO POST - NO EVIDENCE OF ORIGINAL CORNER FOUND**

**GLO ORIGINAL SURVEY PERFORMED BY JOSEPH FLETCHER UNDER CONTRACT DATED 3 SEPT. 1816**

**PLATS**

- |             |                                       |                  |
|-------------|---------------------------------------|------------------|
| L. 33 P. 2  | "B.E. TAYLOR'S SOUTHLAWN SUBDIVISION" | OCTOBER 11, 1915 |
| L. 33 P. 58 | "B.E. TAYLOR'S SOUTHLAWN NO. 2"       | DECEMBER 8, 1915 |
| L. 35 P. 86 | "ROBERT M. GRINDLEY'S RE-SUBDIVISION" | JUNE 23, 1916    |

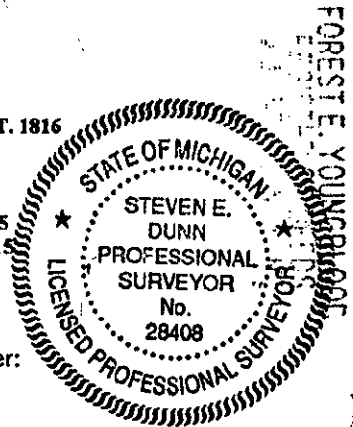

**B. Description of corner evidence found and/or method applied in restoring or reestablishing corner:**

**NO EVIDENCE OF CORNER FOUND  
RE-ESTABLISHED CORNER USING STONE CURB SPLITS WITH REFERENCE TO THE ABOVE LISTED PLATS.  
VERIFIED LOCATION WITH FOUND IRONS AND SIDEWALK SPLITS.**

**FIELD MEASUREMENTS AND RECORDED DISTANCES**

**E-12 TO E-13 2643.32' (M.)**

**PLACED WAYNE COUNTY REMONUMENTATION MARKER AND ALUMINUM CAP #28408 ON 1/2" x 18" IRON WITHIN A MONUMENT BOX.**

**C. Description of monument for corner and accessories established to perpetuate locating the position of the corner:**

**E-12 T.1S., R.11E. WAYNE COUNTY REMONUMENTATION AND ALUMINUM CAP #28408 ON 1/2" x 18" IRON IN A MONUMENT BOX.**

**WITNESSES**

- |          |        |  |
|----------|--------|--|
| AZ. 214° | 47.52' | SET PK NAIL AND W.C.R. TAG IN NORTHWEST FACE OF UTILITY POLE |
| AZ. 133° | 43.91' | SET PK NAIL AND W.C.R. TAG IN NORTH FACE OF UTILITY POLE     |
| AZ. 40°  | 44.50' | SET PK NAIL AND W.C.R. TAG IN SOUTHEAST FACE OF UTILITY POLE |
| AZ. 310° | 45.33' | SET PK NAIL AND W.C.R. TAG IN SOUTH FACE OF UTILITY POLE     |

**THE SELECTED LOCATION FOR THIS PROPERTY CONTROLLING MONUMENT IS ACCEPTED AS A CAREFUL AND FAITHFUL DETERMINATION OF THE POSITION AS INDICATED.**

Signed by Steven E. Dunn

Date DECEMBER 5, 1995

Surveyor's Michigan License No. 28408

*4  
7 D  
718.*