

RC 1164

FEB 28 1994

LAND CORNER RECORDATION CERTIFICATE
Filing Requirement of Act 74, Mich. P.A. 1970

LI 26992 PA 851

For corners in COMMISSION

Wayne (County)	Located In: City of Detroit	Corner Code # G-3
1. Public Land Survey	T <u>1</u> S R <u>11</u> E	_____
	T _____ R _____	_____
	T _____ R _____	_____
	T _____ R _____	_____
2. Property Controlling in Section	S _____ T _____ R _____	_____
	S _____ T _____ R _____	_____
3. Miscellaneous Property in Sec.	S _____ T _____ R _____	_____
	S _____ T _____ R _____	_____
4. Lot No. _____, Recorded Plat _____		
5. Private Claims _____		


Compliance with
ACT 345, P.A. 1990

APPROVED ON: 11-30-93 *[Signature]*
WAYNE COUNTY REMONUMENTATION
PEER GROUP COMMITTEE


Register of Deeds Stamp & File Number

I, Steven E. Dunn, in a field survey on November 6, 1993, do hereby certify that under requirements of P.A. 74, Michigan P.A. of 1970, the corner points mentioned in lines 1 and 2 above were in conformance with regulations and rules therefore as required in the current manual of survey instructions of the United States Department of the Interior, Bureau of Land Management or by a decree of a Court of Law and/or that the corner points mentioned in lines 3, 4 and 5 above were in conformance with the rules of the Michigan Board of Land Surveyors or by a Decree of a Court of Law; established, re-established, monumented, re-monumented, recovered, found as expressed below:

NOTE: Not more than 4 corners, all in the same town and range, may be recorded on this certificate.

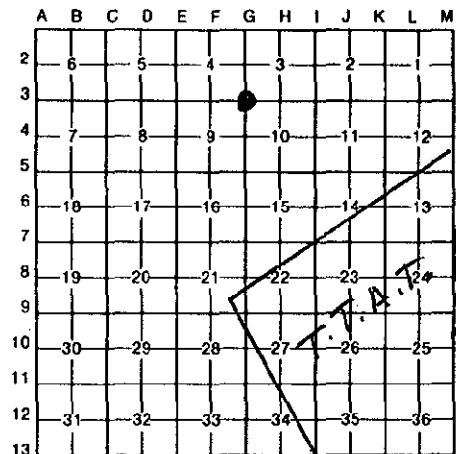

A. Description of original monument and accessories and/or subsequent restoration:
GLO - Post No GLO Witnesses remain
GLO original survey performed by Joseph Fletcher under contract dated 3 Sep., 1816.

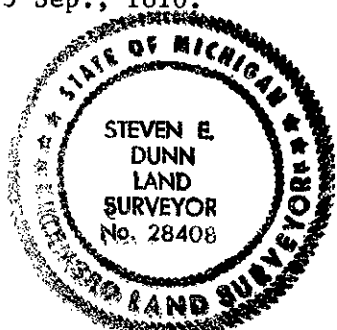

B. Description of corner evidence found and/or method applied in restoring or reestablishing corner:
Fd. concrete monument in monument box.

Verified using found irons & curb splits along 7 Mile & Livernois with reference to Sherwood Forest Sub'n L.39, P.11, W.C.R; Palmer Park Gardens Sub'n L.30, P.52, W.C.R.; Cantibury Gardens Sub'n L.37, P.65, W.C.R; & Ridgefield Sub'n L.48, P.2, W.C.R.

Placed Wayne County Remonumentation Marker on Iron Rod driven into Iron Pipe in concrete monument within a monument box.

C. Description of monument for corner and accessories established to perpetuate locating the position of the corner:
Wayne County Remonumentation marker on iron rod driven into iron pipe in concrete monument in monument box

Witnesses

- Fd. P.K. Nail and W.C.R. tag @ SW face U.P. N.68°W - 77.11'
- Fd. P.K. Nail and W.C.R. tag @ South face U.P. N.73°E - 72.60'
- Fd. P.K. Nail and W.C.R. tag @ SW face U.P. S.51°E - 75.95'
- Fd. "+" cut in NE corner concrete base for L.P.
- Set P.K. Nail and W.C.R. witness tag at "+" S.41°W. - 77.13'

The selected location is a careful and faithful perpetuation of the position of the original corner

Signed by Steven E. Dunn Date Nov. 30, 1993

Surveyor's Michigan License No. 28408

93 NOV 30 PM 4:23
FOREST E. YOUNGBLOOD
REGISTER OF DEEDS
WAYNE COUNTY, MI