

FEB 28 1994

RC 1166

COMMISSIONER

LAND CORNER RECORDATION CERTIFICATE
Filing Requirement of Act 74, Mich. P.A. 1970

LI 26992 PA 853

For corners in

Wayne
(County)

Located In: Greenfield Twp. Corner Code # _____

1. Public Land Survey	T <u>1</u> S	R <u>11</u> E	<u>G-11</u>
	T _____	R _____	_____
	T _____	R _____	_____
	T _____	R _____	_____
2. Property Controlling in Section	S _____	T _____	R _____
	S _____	T _____	R _____
3. Miscellaneous Property in Sec.	S _____	T _____	R _____
	S _____	T _____	R _____

4. Lot No. _____, Recorded Plat _____

5. Private Claims _____

Compliance with
ACT 345, P.A. 1990


APPROVED ON: 11-18-93 *DBL*

WAYNE COUNTY REMONUMENTATION
PEER GROUP COMMITTEE

Register of Deeds Stamp & File Number

I, Steven E. Dunn, in a field survey on November 8, 19 93, do hereby certify that under requirements of P.A. 74, Michigan P.A. of 1970, the corner points mentioned in lines 1 and 2 above were in conformance with regulations and rules therefore as required in the current manual of survey instructions of the United States Department of the Interior, Bureau of Land Management or by a decree of a Court of Law and/or that the corner points mentioned in lines 3, 4 and 5 above were in conformance with the rules of the Michigan Board of Land Surveyors or by a Decree of a Court of Law, established, re-established, monumented, re-monumented, recovered, found as expressed below:

NOTE: Not more than 4 corners, all in the same town and range, may be recorded on this certificate.

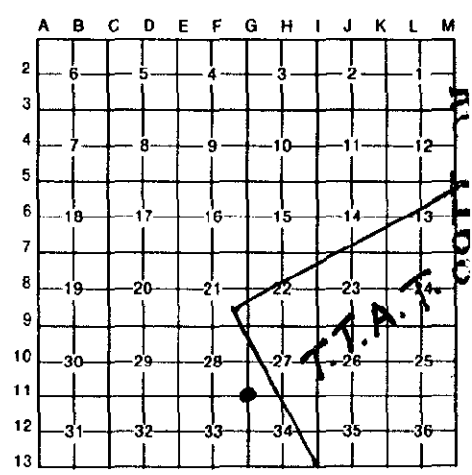

A. Description of original monument and accessories and/or subsequent restoration:
G.L.O. Survey contracted to Joseph Fletcher on 3 Sep. 1816

No G.L.O. Witnesses remain.

- Plats
- L. 32, P. 46 - Hutton & Nalls Grand River High Land Subd'n
 - L. 34, P. 86 - Elmhurst Park Subdivision
 - L. 34, P. 50 - Pontchartrain Heights Sub'n.
 - L. 41, P. 99 - The Foley Farm Subdivision.



B. Description of corner evidence found and/or method applied in restoring or reestablishing corner:

No corner evidence found
Reestablished corner using found iron and splitting back of walks with reference to above plats. Verified distances.

Placed Wayne County Remonumentation Marker and plastic cap # 28408 on 1/2" X 18" iron within a monument box.

C. Description of monument for corner and accessories established to perpetuate locating the position of the corner:

G-11, T.1S.,R.11E.
1/2" X 18" Iron with W.C.R. marker and cap #28408 in monument box

- Witnesses
- N.45°W. 64.71' Set P.K. nail and W.C.R. witness tag in asphalt at back of curb
 - S.55°W. 55.42' Set P.K. nail and W.C.R. witness tag in asphalt at base of curb
 - N.51°E. 58.59' Set P.K. nail and W.C.R. witness tag in top of concrete curb
 - S.51°E. 58.41' Set P.K. nail and W.C.R. witness tag in top of concrete curb

The selected location is a careful and faithful reestablishment of the position of the original corner.

Signed by Steven E. Dunn Date Nov. 30, 1993

Surveyor's Michigan License No. 28408

33 NOV 30 PM 4:26
 FOREST E. YOUNGBLOOD
 REGISTER OF DEEDS
 WAYNE COUNTY, MI