

FEB 23 1994

LI 26992 PA 854

COMMISSION

LAND CORNER RECORDATION CERTIFICATE
Filing Requirement of Act 74, Mich. P.A. 1970

For corners in

Wayne (County)	Located In: City of Detroit	Corner Code -#
1. Public Land Survey	T <u>1 S</u> R <u>11 E</u>	<u>K-3</u>
	T _____ R _____	_____
	T _____ R _____	_____
	T _____ R _____	_____
2. Property Controlling in Section	S _____ T _____ R _____	_____
	S _____ T _____ R _____	_____
3. Miscellaneous Property in Sec.	S _____ T _____ R _____	_____
	S _____ T _____ R _____	_____

Compliance with
ACT 345, P.A. 1990

APPROVED ON: 11-18-93 DPL
WAYNE COUNTY REMONUMENTATION
PEER GROUP COMMITTEE

Register of Deeds Stamp & File Number

4. Lot No. _____, Recorded Plat _____
5. Private Claims _____

I, Steven E. Dunn, in a field survey on November 8, 19 93, do hereby certify that under requirements of P.A. 74, Michigan P.A. of 1970, the corner points mentioned in lines 1 and 2 above were in conformance with regulations and rules therefore as required in the current manual of survey instructions of the United States Department of the Interior, Bureau of Land Management or by a decree of a Court of Law and/or that the corner points mentioned in lines 3, 4 and 5 above were in conformance with the rules of the Michigan Board of Land Surveyors or by a Decree of a Court of Law; established, re-established, monumented, re-monumented, recovered, found as expressed below:

NOTE: Not more than 4 corners, all in the same town and range, may be recorded on this certificate.

A. Description of original monument and accessories and/or subsequent restoration:
GLO Post - No original evidence found.

GLO Original survey performed by Joseph Fletcher under contract dated 3 Sep. 1816.

Plats:

- L.67 - P.16 James E. O'Flaherty's Log Cabin Subdivision No. 1
- L.33 - P.88 Lindale Gardens Sub'n.
- L.32 - P.94 Lindale Park
- L-62 - P.71 Blanck & Gargaro Co. Inc. Subdivision

B. Description of corner evidence found and/or method applied in restoring or reestablishing corner:
No evidence of corner found.

Re-establish corner using existing buildings and back of walk splits with reference to above plats and surveys recorded in L.21097, P.215 & 216 and L.21769, P.820 & 821 (W.C.R.) Verified distances.

Placed Wayne County Remonumentation marker and plastic cap #28408 on 1/2" X 18" iron within a monument box.

C. Description of monument for corner and accessories established to perpetuate locating the position of the corner:

Wayne County remonumentation marker and plastic cap #28408 on 1/2" X 18" Iron within a monument box.



Witnesses

- N.44°W. 37.66' - Set P.K. Nail and W.C.R. witness tag in utility pole.
- N.31°E. 46.62' - Set P.K. Nail and W.C.R. witness tag in utility pole.
- S.52°E. 41.80' - Set P.K. Nail and W.C.R. witness tag in utility pole.
- S.60°W. 44.47' - Set P.K. Nail and W.C.R. witness tag in utility pole.

The selected location is a careful and faithful reestablishment of the position of the original corner.

Signed by Steven E. Dunn Date Nov. 30, 1993

Surveyor's Michigan License No. 28408

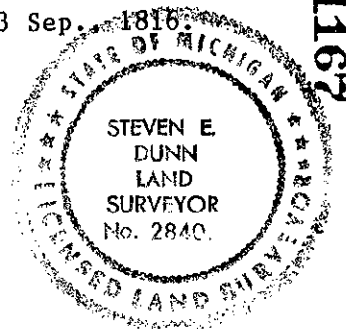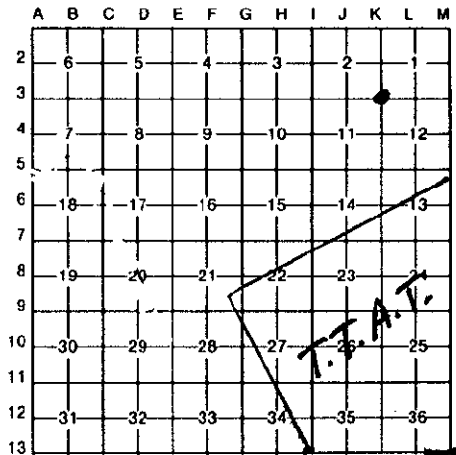

93 NOV 30 PM 4: 26
 FOREST E. YOUNG BLOOD
 REGISTER OF DEEDS
 WAYNE COUNTY, MI