

FEB 28 1994

LAND CORNER RECORDATION CERTIFICATE
Filing Requirement of Act 74, Mich. P.A. 1970

For corners in

Wayne

COMMISSION

(County)

Located In:

Corner Code #


City of: Detroit

1. Public Land Survey	T	<u>1</u> S	R	<u>12</u> E	<u>C-1</u>
	T	___	R	___	___
	T	___	R	___	___
	T	___	R	___	___
2. Property Controlling in Section	S	___	T	___	R
	S	___	T	___	R
3. Miscellaneous Property in Sec.	S	___	T	___	R
	S	___	T	___	R

Compliance with ACT 345, P.A. 1990
APPROVED ON: 11-18-93 *DBL*
WAYNE COUNTY REMONUMENTATION
PEER GROUP COMMITTEE

Register of Deeds Stamp & File Number

- 4. Lot No. _____, Recorded Plat _____
- 5. Private Claims _____

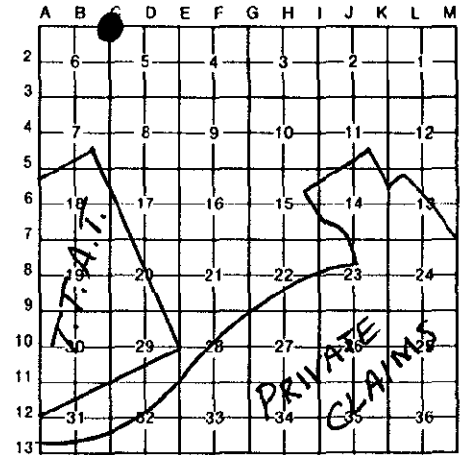


I, Martin C. Dunn, in a field survey on November 8, 19 93, do hereby certify that under requirements of P.A. 74, Michigan P.A. of 1970, the corner points mentioned in lines 1 and 2 above were in conformance with regulations and rules therofore as required in the current manual of survey instructions of the United States Department of the Interior, Bureau of Land Management or by a decree of a Court of Law and/or that the corner points mentioned in lines 3, 4 and 5 above were in conformance with the rules of the Michigan Board of Land Surveyors or by a Decree of a Court of Law; established, re-established, monumented, re-monumented, recovered, found as expressed below:

NOTE: Not more than 4 corners, all in the same town and range, may be recorded on this certificate.

A. Description of original monument and accessories and/or subsequent restoration:

GLO - Post set in original survey by Joseph Fletcher contracted Sept. 3, 1816
(No G.L.O. evidence found)
L.C.R.C. L. 17912 P. 950 & 951 - 1/2" iron in monument box

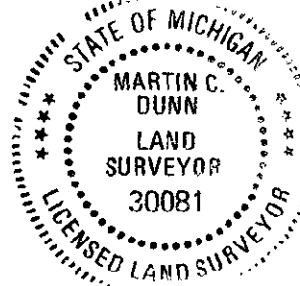

RC 1177

B. Description of corner evidence found and/or method applied in restoring or reestablishing corner:

Found 1/2" iron in monument box as per L.C.R.C. L. 17912 P. 950 & 951
Found witnesses power pole
All other witnesses non existent

210° AZ - 58.72'

93 NOV 30 PM 4: 24
DRESTE YOUNGBL OOD
REGISTER OF DEEDS
WAYNE COUNTY MI

C. Description of monument for corner and accessories established to perpetuate locating the position of the corner:

Wayne County Remonumentation marker and plastic cap #30081 over existing 1/2" iron as per L.C.R.C. above

Witnesses

- Found Nail in power pole 210° AZ - 58.72'
- Set P.K. Nail with W.C.R. tag in power pole 20° AZ - 88.70'
- Set P.K. Nail with W.C.R. tap in power pole 150° AZ - 80.09'
- Set P.K. Nail with W.C.R. tap in power pole 292° AZ - 83.03'
- Set P.K. Nail with W.C.R. tap in power pole 125° AZ - 59.43'

The selected location is a careful and faithful perpetuation of the position of the original corner

Signed by Martin C. Dunn

Date 11/17/93

Surveyor's Michigan License No. 30081