

RC 1178

FEB 28 1994

LAND CORNER RECORDATION CERTIFICATE
Filing Requirement of Act 74, Mich. P.A. 1970

U26992 PA 865

For corners in COMMISSION

<u>Wayne</u> (County)	Located In: City of Detroit	Corner Code # <u>C-4</u>
1. Public Land Survey	T <u>1</u> S R <u>12</u> E	<u>C-4</u>
	T _____ R _____	_____
	T _____ R _____	_____
	T _____ R _____	_____
2. Property Controlling in Section	S _____ T _____ R _____	_____
	S _____ T _____ R _____	_____
3. Miscellaneous Property in Sec.	S _____ T _____ R _____	_____
	S _____ T _____ R _____	_____


Compliance with
ACT 345, P.A. 1990

APPROVED ON: 11-18-93 *DBL*
WAYNE COUNTY REMONUMENTATION
PEER GROUP COMMITTEE

Register of Deeds Stamp & File Number

4. Lot No. _____, Recorded Plat _____
5. Private Claims _____


I, Martin C. Dunn, in a field survey on November 4, 19 93, do hereby certify that under requirements of P.A. 74, Michigan P.A. of 1970, the corner points mentioned in lines 1 and 2 above were in conformance with regulations and rules therefore as required in the current manual of survey instructions of the United States Department of the Interior, Bureau of Land Management or by a decree of a Court of Law and/or that the corner points mentioned in lines 3, 4 and 5 above were in conformance with the rules of the Michigan Board of Land Surveyors or by a Decree of a Court of Law; established, re-established, monumented, re-monumented, recovered, found as expressed below.

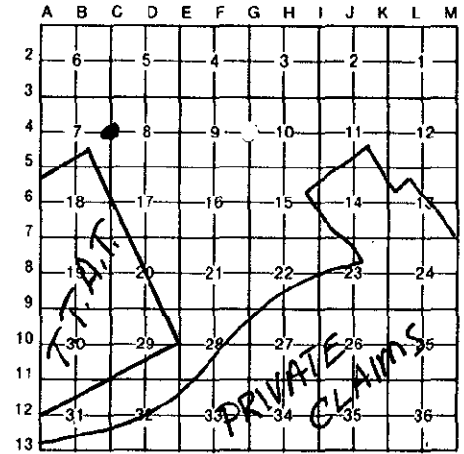

NOTE: Not more than 4 corners, all in the same town and range, may be recorded on this certificate.

A. Description of original monument and accessories and/or subsequent restoration:

- GLO - Post set in original survey by Joseph Fletcher contracted Sept 3, 1816 (No G.L.O. witnesses remain)
- L.C.R.C.L. 25064 P. 947 - 1/2" iron bar with cap #21566 (no witnesses found)

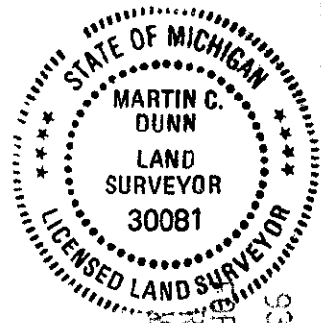

B. Description of corner evidence found and/or method applied in restoring or reestablishing corner:

No evidence of original corner
Found 1/2" iron bar #21566 as per L.C.R.C. L. 25064 P. 947

93 NOV 30 PM 4: 24
FORESTER YOUNGBLOOD
REGISTER OF DEEDS
WAYNE COUNTY, MI

C. Description of monument for corner and accessories established to perpetuate locating the position of the corner:

(Remonumentation marker and plastic cap #30081 over existing 1/2" iron bar)

Witnesses

- City of Detroit BM 43°AZ. - 42.79'
- Set P.K. Nail with W.C.R. tag S. face utility pole 60°AZ. - 54.59'
- Set P.K. Nail with W.C.R. tag W. face utility pole 144°AZ. - 42.24'
- Set P.K. Nail with W.C.R. tag NW face utility pole 242°AZ. - 57.74'
- Set P.K. Nail with W.C.R. tag NE face utility pole 338°AZ. - 66.97'

Signed by Martin C. Dunn Date 11/30/93
Surveyor's Michigan License No. 30081