

FEB 28 1994

LAND CORNER RECORDATION CERTIFICATE
Filing Requirement of Act 74, Mich. P.A. 1970

For corners in COMMISSION


LI 26992 PA 866

<u>Wayne</u> (County)	Located in: City of Detroit	Corner Code # C-5
1. Public Land Survey	T <u>1</u> S R <u>12</u> E	<u>C-5</u>
	T _____ R _____	_____
	T _____ R _____	_____
	T _____ R _____	_____
2. Property Controlling in Section	S _____ T _____ R _____	_____
	S _____ T _____ R _____	_____
3. Miscellaneous Property in Sec.	S _____ T _____ R _____	_____
	S _____ T _____ R _____	_____

Compliance with ACT 345, P.A. 1990
APPROVED ON: 11-30-93 [Signature]
WAYNE COUNTY REMONUMENTATION PEER GROUP COMMITTEE

Register of Deeds Stamp & File Number

4. Lot No. _____, Recorded Plat _____
5. Private Claims _____

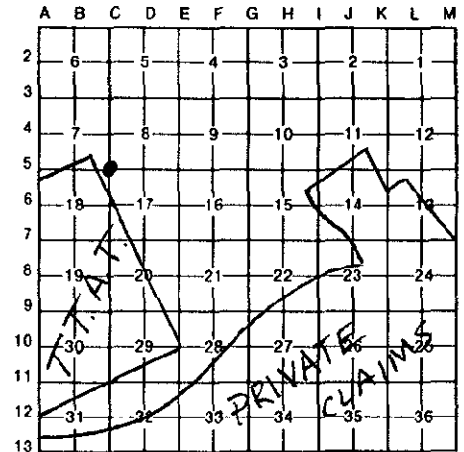


I, Martin C. Dunn, in a field survey on November 4, 19 93, do hereby certify that under requirements of P.A. 74, Michigan P.A. of 1970, the corner points mentioned in lines 1 and 2 above were in conformance with regulations and rules therefore as required in the current manual of survey instructions of the United States Department of the Interior, Bureau of Land Management or by a decree of a Court of Law and/or that the corner points mentioned in lines 3, 4 and 5 above were in conformance with the rules of the Michigan Board of Land Surveyors or by a Decree of a Court of Law: established, re-established, monumented, re-monumented, recovered, found as expressed below:

NOTE: Not more than 4 corners, all in the same town and range, may be recorded on this certificate.

A. Description of original monument and accessories and/or subsequent restoration:
GLO - Post No original evidences found.

GLO original survey performed by Joseph Fletcher under contract dated 3 Sept., 1816.

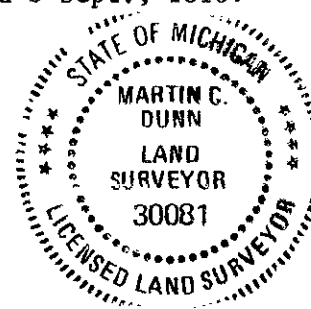

RC 1179

B. Description of corner evidence found and/or method applied in restoring or reestablishing corner:
Found 3/4" iron rod, #21566, in monument box

Verified using found irons & curb splits along McNichols & Ryan with reference to Mechanic's Park John M. Dweyer's L.26, P.1, W.C.R. & Downie's Aladdin Sub'n L.35, P.54, W.C.R.

Placed Wayne County Remonumentation marker and plastic cap #30081 over existing corner

C. Description of monument for corner and accessories established to perpetuate locating the position of the corner:
Wayne County Remonumentation marker and plastic cap #30081 on 3/4" Iron rod.

Witness

- City of Detroit BM NW cor. intersection 318°AZ. - 53.22
- Set P.K. Nail with W.C.R. tag on NW face utility pole on NE cor. intersection 54°AZ-47.36
- Set P.K. Nail with W.C.R. tag on W. face asphalt on SE cor. intersection 140°AZ-77.89
- Set P.K. Nail with W.C.R. tag on E face utility pole on SW cor. intersection 200°AZ-25.46
- Set P.K. Nail with W.C.R. tag on S face utility pole on NW cor. intersection 307°AZ-61.34

The selected location is a careful and faithful reestablishment of the position of the original corner.

Signed by Martin C. Dunn Date 11/30/93

Surveyor's Michigan License No. 30081

93 NOV 30 PM 1:24
FOREST COUNTY RECORDS
WAYNE COUNTY, MI