SURVEY & REMONUMENTATION

FEB 28 1994

COMMISSION

RC 1180

LR 26992 PA 867

LAND CORNER RECORDATION CERTIFICATE

Filing Requirement of Act 74, Mich. P.A. 1970

For corners in Wayne (County)

Located In: City of Detroit

Corner Code ##

1. Public Land Survey — T 1 S R 12 E — D-5
   T ___ R ___
   T ___ R ___
   T ___ R ___
2. Property Controlling in Section — S ___ T ___ R ___
   S ___ T ___ R ___
3. Miscellaneous Property in Sec. — S ___ T ___ R ___
   S ___ T ___ R ___

Compliance with ACT 345, P.A. 1990

APPROVED ON: 11-30-93 DBL

WAYNE COUNTY REMONUMENTATION PEER GROUP COMMITTEE

Register of Deeds Stamp & File Number

4. Lot No. _____, Recorded Plat _____
5. Private Claims _____

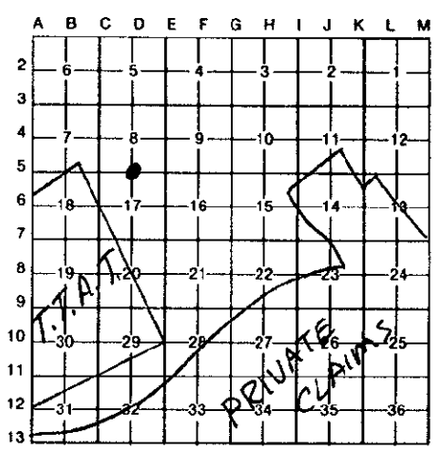

I, Martin C. Dunn, in a field survey on November 8, 19 93, do hereby certify that under requirements of P.A. 74, Michigan P.A. of 1970, the corner points mentioned in lines 1 and 2 above were in conformance with regulations and rules therefore as required in the current manual of survey instructions of the United States Department of the Interior, Bureau of Land Management or by a decree of a Court of Law and/or that the corner points mentioned in lines 3, 4 and 5 above were in conformance with the rules of the Michigan Board of Land Surveyors or by a Decree of a Court of Law; established, re-established, monumented, re-monumented, recovered, found as expressed below:

NOTE: Not more than 4 corners, all in the same town and range, may be recorded on this certificate.

A. Description of original monument and accessories and/or subsequent restoration:

GLO - Post set in original survey by Joseph Fletcher Contracted Sept. 3, 1816
(No GLO evidence found)
LCRC L. 23769 P.123 - 5/8" iron with cap #21566 within monument box

STATE OF MICHIGAN
MARTIN C. DUNN
LAND SURVEYOR
30081
LICENSED LAND SURVEYOR

RC 1180

B. Description of corner evidence found and/or method applied in restoring or reestablishing corner:

Found 5/8"iron with cap #21566 within monument box.
Verified using the L.C.R.C. (stated above) witnesses listed below

-1/2" iron rod at NW cor. Lot 28 of I. G. Kolowich's Sub.	N11°E - 148.30'
-P.K. nail at SW cor. Lot 28 of I. G. Kolowich's Sub.	N30°E - 52.55'
-Center of HPFS/DFD manhole	S38°W - 81.97'
-Center of Detroit water supply gate manhole	S13°E - 53.31'
-Top of fire hydrant	N09°W - 45.17'

93 NOV 30 PM 4:24
FORREST E. YOUNGBLOOD
REGISTER OF DEEDS
WAYNE COUNTY, MI

C. Description of monument for corner and accessories established to perpetuate locating the position of the corner:

Wayne County Remonumentation marker and plastic cap #30081 over existing 5/8" iron as per L.C.R.C. state above

Witnesses

-1/2" iron rod at NW cor. Lot 28 of I. G. Kolowich's Sub.	N11°E - 148.30'
-P.K. Nail at SW cor. Lot 28 of I. G. Kolowich's Sub.	N30°E - 52.55'
-Center of HPFS/DFD manhole	S38°W - 81.97'
-Center of Detroit water supply gate manhole	S13°E - 53.31'
-Top of fire hydrant	N09°W - 45.17'
-Set P.K. Nail with W.C.R. tag E face utility pole	S22°W - 74.23'
-Set P.K. Nail with W.C.R. tag E face utility pole	S83°E - 61.09'

The selected location is a careful and faithful reestablishment of the position of the orig. cor.

Signed by Martin C. Dunn Date 11/30/93

Surveyor's Michigan License No. 30081

FORM APPROVED BY MICHIGAN STATE BOARD OF LAND SURVEYORS, JAN. 28, 1971
REVISED MAY 14, 1975
REVISED JAN., 1983