

SURVEY & RECONSTRUCTION

RC 1181

LI 26992 PA 868

FEB 28 1994

LAND CORNER RECORDATION CERTIFICATE
Filing Requirement of Act 74, Mich. P.A. 1970

For corners in COMMISSION

Table with columns: Located In: (Wayne County, City of Detroit), Corner Code (#), and survey details (Public Land Survey, Property Controlling, etc.)

Compliance with ACT 345, P.A. 1990
APPROVED ON: 11-18-93 [Signature]
WAYNE COUNTY REMONUMENTATION PEER GROUP COMMITTEE

Register of Deeds Stamp & File Number



4. Lot No. , Recorded Plat
5. Private Claims

I, Martin C. Dunn, in a field survey on November 4, 1993, do hereby certify that under requirements of P.A. 74, Michigan P.A. of 1970, the corner points mentioned in lines 1 and 2 above were in conformance with regulations and rules therefore as required in the current manual of survey instructions of the United States Department of the Interior, Bureau of Land Management or by a decree of a Court of Law and/or that the corner points mentioned in lines 3, 4 and 5 above were in conformance with the rules of the Michigan Board of Land Surveyors or by a Decree of a Court of Law; established, re-established, monumented, re-monumented, recovered, found as expressed below:

NOTE: Not more than 4 corners, all in the same town and range, may be recorded on this certificate.

A. Description of original monument and accessories and/or subsequent restoration:

GLO - Post set in original survey by Joseph Fletcher contracted Sep., 3, 1816 (No GLO evidence found)
LCRC L. 23769 P. 122 5/8" iron with cap #21566 in monument box

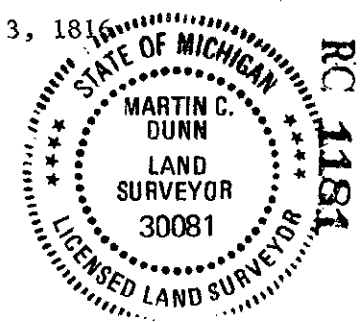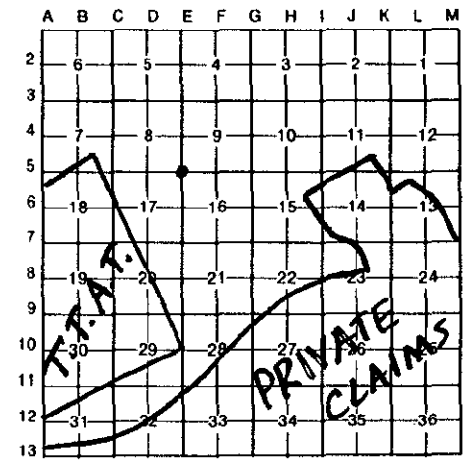

B. Description of corner evidence found and/or method applied in restoring or reestablishing corner:

Found 5/8" iron with cap #21566 in monument box as per L.C.R.C. stated above.
Verified using L.C.R.C. Witnesses
Fence corner at SE corner of Sacred Heart of Mary Cemetery N.01° - 42.33'
Chain link fence corner South 34.70'
(Other witnesses invalid)

C. Description of monument for corner and accessories established to perpetuate locating the position of the corner:

Wayne County Remonumentation marker and plastic cap #30081 over existing 5/8" iron within a monument box.
Witnesses
Found fence corner at SE corner of Sacred Heart of Mary Cemetery N.01°E - 42.33'
Found Chain Link fence corner South 34.70'
- Set P.K. Nail with W.C.R. tag in E. face utility pole 350°AZ. - 27.12'
- Set P.K. Nail with W.C.R. tag in NW face utility pole 62°AZ. - 67.77'
- Set P.K. Nail with W.C.R. tag in SW face utility pole 129°AZ. - 63.42'
- Set P.K. Nail with W.C.R. tag in W. face utility pole 179°AZ. - 33.14'
The selected location is a careful and faithful reestablishment of the position of the original corner.

Signed by Martin C. Dunn Date 11/30/93

Surveyor's Michigan License No. 30081

33 NOV 30 PM 4: 24
FORESTER, YOUNGBLOOD
REGISTER OF DEEDS
WAYNE COUNTY, MI