

FEB 28 1994

LAND CORNER RECORDATION CERTIFICATE
Filing Requirement of Act 74, Mich. P.A. 1970

For corners in

COMMISSION

Wayne (County) Located In: City of Detroit Corner Code #

1. Public Land Survey	T	1S	R	12 E	G-7
	T		R		
	T		R		
	T		R		
2. Property Controlling in Section	S		T	R	
	S		T	R	
3. Miscellaneous Property in Sec.	S		T	R	
	S		T	R	

4. Lot No. _____, Recorded Plat _____

5. Private Claims _____

Compliance with ACT 345, P.A. 1990

APPROVED ON: 11-18-93 DBJ.
WAYNE COUNTY REMONUMENTATION
PEER GROUP COMMITTEE

Register of Deeds Stamp & File Number

I, Martin C. Dunn, in a field survey on November 4, 19 93, do hereby certify that under requirements of P.A. 74, Michigan P.A. of 1970, the corner points mentioned in lines 1 and 2 above were in conformance with regulations and rules therefore as required in the current manual of survey instructions of the United States Department of the Interior, Bureau of Land Management or by a decree of a Court of Law and/or that the corner points mentioned in lines 3, 4 and 5 above were in conformance with the rules of the Michigan Board of Land Surveyors or by a Decree of a Court of Law; established, re-established, monumented, re-monumented, recovered, found as expressed below:

NOTE: Not more than 4 corners, all in the same town and range, may be recorded on this certificate.

A. Description of original monument and accessories and/or subsequent restoration:

GLO - Post set in original survey by Joseph Fletcher contracted Sept. 3 1816
(No GLO witnesses found)
L.C.R.C. L. 20578 P. 155 - P.K. Nail

B. Description of corner evidence found and/or method applied in restoring or reestablishing corner:

No evidence of original corner
Found P.K. Nail as per L.C.R.C. L. 20578 P.155
Verified using found witness
Traffic signal

135° AZ - 54.02'


C. Description of monument for corner and accessories established to perpetuate locating the position of the corner:

Placed Wayne County Remonumentation marker and plastic cap #30081 on 18" iron within a monument box

Witnesses

- Fd. traffic signal 152° AZ - 54.02'
- Set P.K. Nail with W.C.R. tag in sidewalk 77° AZ - 52.33
- Set P.K. Nail with W.C.R. tap in sidewalk 146° AZ - 55.37'
- Set P.K. Nail with W.C.R. tap in sidewalk 259° AZ - 56.93'
- Set P.K. Nail with W.C.R. tap in sidewalk 331° AZ - 58.80'

The selected location is a careful and faithful reestablishment of the position of the original corner

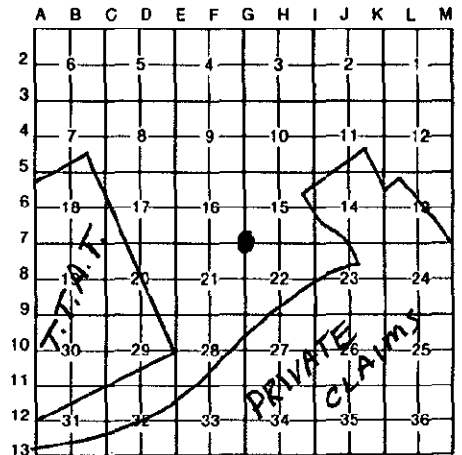

RC 1182
33 NOV 30 PM 4:24
FOREST E. YOUNGBLOOD
REGISTER OF DEEDS
WAYNE COUNTY, MI

Signed by Martin C. Dunn Date 11/30/93

Surveyor's Michigan License No. 30081