

SUBJECT & REASON FOR APPLICATION

RC 1183

LI 26992 PA 870

FEB 28 1994

LAND CORNER RECORDATION CERTIFICATE
Filing Requirement of Act 74, Mich. P.A. 1970

For corners in

Wayne COMMISSION
(County)

Located In:

Corner Code #

City of Detroit


- 1. Public Land Survey T 1 S R 12 E H-1
T R
T R
T R
- 2. Property Controlling S T R
in Section S T R
- 3. Miscellaneous S T R
Property in Sec. S T R
- 4. Lot No. _____, Recorded Plat _____
- 5. Private Claims _____

Compliance with ACT 345, P.A. 1990
APPROVED ON: 11-18-93 [Signature]
WAYNE COUNTY REMONUMENTATION
PEER GROUP COMMITTEE

Register of Deeds Stamp & File Number

I, Martin C. Dunn, P.S. in a field survey on November 4, 1993, do hereby certify that under requirements of P.A. 74, Michigan P.A. of 1970, the corner points mentioned in lines 1 and 2 above were in conformance with regulations and rules therefore as required in the current manual of survey instructions of the United States Department of the Interior, Bureau of Land Management or by a decree of a Court of Law and/or that the corner points mentioned in lines 3, 4 and 5 above were in conformance with the rules of the Michigan Board of Land Surveyors or by a Decree of a Court of Law; established, re-established, monumented, re-monumented, recovered, found as expressed below:

NOTE: Not more than 4 corners, all in the same town and range, may be recorded on this certificate.

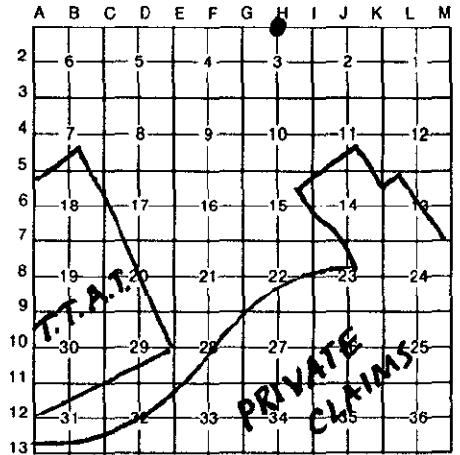

A. Description of original monument and accessories and/or subsequent restoration:


GLO-Post set in original survey by Joseph Fletcher contracted Sept 3, 1816 (No original evidence found)
L.C.R.C. L. 20303 P. 259 & 260 - mon box

B. Description of corner evidence found and/or method applied in restoring or reestablishing corner:

Found Mon Box as per L.C.R.C. stated above with spike
Verified using the following witnesses:
- Found Nail W/survey cap in wood pole 350°AZ. - 36.25'
- Found Nail W/survey cap in wood pole 135°AZ. - 90.7'
Replaced spike with 1/2" X 18" iron rod with Wayne County Remonumentation marker and plastic cap #30081

C. Description of monument for corner and accessories established to perpetuate locating the position of the corner:

Wayne County Remonumentation marker and plastic cap #30081 over 18" iron rod
Witnesses
- Found Nail W/survey cap in wood pole 350°AZ. - 36.25
- Found Nail W/survey cap in wood pole 135°AZ. - 90.7
- Center of Hydrant 61°AZ. - 71.06'
- Set P.K. with W.C.R. tag in sidewalk 213°AZ. - 57.21
The selected location is a careful and faithful perpetuation of the position of the original corner

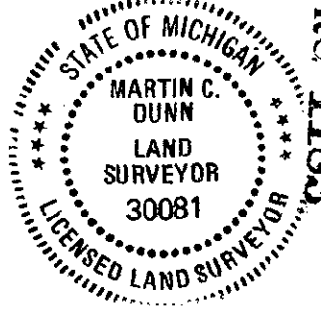

93 NOV 30 PM 4:24
FORESTER, YOUNGBLOOD
REGISTER OF DEEDS
WAYNE COUNTY, MI

Signed by Martin C. Dunn Date 11/30/93

Surveyor's Michigan License No. 30081