

FEB 28 1994

LAND CORNER RECORDATION CERTIFICATE
Filing Requirement of Act 74, Mich. P.A. 1970

LI 26992 PA 871


For corners in COMMISSION

Wayne (County)	Located In: City of Detroit	Corner Code -## L-3
1. Public Land Survey	T 1 S R 12 E	L-3
	T R	
	T R	
	T R	
2. Property Controlling in Section	S T R	
	S T R	
3. Miscellaneous Property in Sec.	S T R	
	S T R	

Compliance with
ACT 345, P.A. 1990
APPROVED ON: 11-18-93 [Signature]
WAYNE COUNTY REMONUMENTATION
PEER GROUP COMMITTEE

Register of Deeds Stamp & File Number


4. Lot No. _____, Recorded Plat _____
5. Private Claims _____

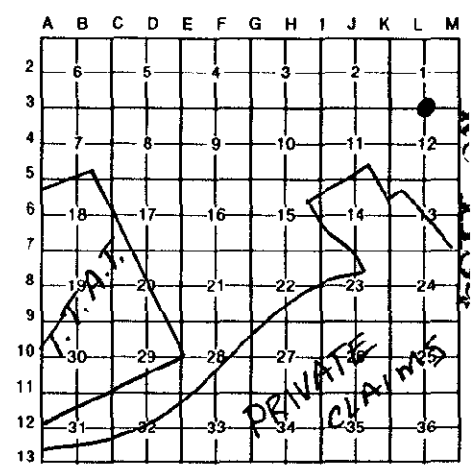

I, Martin C. Dunn, in a field survey on November 8, 19 93, do hereby certify that under requirements of P.A. 74, Michigan P.A. of 1970, the corner points mentioned in lines 1 and 2 above were in conformance with regulations and rules therefore as required in the current manual of survey instructions of the United States Department of the Interior, Bureau of Land Management or by a decree of a Court of Law and/or that the corner points mentioned in lines 3, 4 and 5 above were in conformance with the rules of the Michigan Board of Land Surveyors or by a Decree of a Court of Law; established, re-established, monumented, re-monumented, recovered, found as expressed below.

NOTE: Not more than 4 corners, all in the same town and range, may be recorded on this certificate.

A. Description of original monument and accessories and/or subsequent restoration:
G.L.O. - Post set in original government survey by Joseph Fletcher under contract dated Sept 3, 1816.
(No original evidence found)

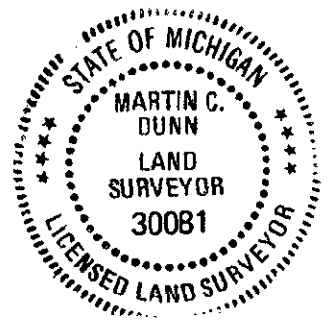

B. Description of corner evidence found and/or method applied in restoring or reestablishing corner:
No evidence of corner found

Reestablish corner using found irons along 7 Mile & Chalmers with reference to Gratiot Park Sub'n, L.32, P.66, W.C.R. & Seymour & Troesters Montclair Heights Sub'n #2, L.30, P.12, W.C.R.

Verified iron locations using back of curb splits
Place Wayne County Remonumentation marker and plastic cap #30081 on 1/2" X 18" iron within mon. box.

C. Description of monument for corner and accessories established to perpetuate locating the position of the corner:
Wayne County Remonumentation marker and plastic cap #30081 on 1/2" X 18" iron within mon. box.

93 NOV 30 PM 4:24
FOREST E. YOUNGBLOOD
REGISTERED DEEDS
WAYNE COUNTY, MI

- Witnesses
- Set P.K. nail with W.C.R. tag in sidewalk 22°AZ. - 28.16'
 - Set P.K. nail with W.C.R. tag in sidewalk 139°AZ. - 40.27'
 - Set P.K. nail with W.C.R. tag in sidewalk 226°AZ. - 40.06'
 - Set P.K. nail with W.C.R. tag in N.E. face of utility pole. 295°AZ. - 55.43'

The selected location is a careful and faithful reestablishment of the position of the original corner.

Signed by Martin C. Dunn Date 11/30/93
Surveyor's Michigan License No. 30081