SURVEY & REMONUMENTATION

APR 0 5 1996

LIBER 28452 PAGE 772

LAND CORNER RECORDATION CERTIFICATE

Filing Requirement of Act 74, Mich. P.A. 1970

For corners in COMMISSION

WAYNE (County)

Located In: HAMTRAMCK TWP (NOW CITY OF DETROIT)

Corner Code #

1. Public Land Survey		T 1S	R 12E	M-2
		T	R	
		T	R	
		T	R	
2. Property Controlling	S	T	R	
in Section	S	T	R	
3. Miscellaneous	S	T	R	
Property in Sec.	S	T	R	

Compliance with ACT 345, P.A. 1990

APPROVED ON: DEC 5 1995 MCD.

WAYNE COUNTY REMONUMENTATION PEER GROUP COMMITTEE

Register of Deeds Stamp & File Number

4. Lot No. _____, Recorded Plat _____

5. Private Claims _____

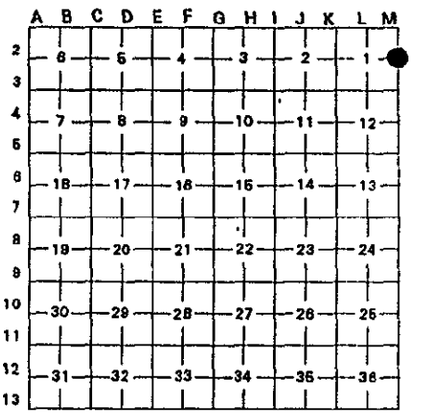

I, MARTIN C. DUNN, in a field survey on OCTOBER 29, 19 95, do hereby certify that under requirements of P.A. 74, Michigan P.A. of 1970, the corner points mentioned in lines 1 and 2 above were in conformance with regulations and rules therefore as required in the current manual of survey instructions of the United States Department of the Interior, Bureau of Land Management or by a decree of a Court of Law and /or that the corner points mentioned in lines 3, 4 and 5 above were in conformance with the rules of the Michigan Board of Land Surveyors or by a Decree of a Court of Law; established, re-established, monumented, re-monumented, recovered, found as expressed below:

NOTE: Not more than 4 corners, all in the same town and range, may be recorded on this certificate.

A. Description of original monument and accessories and/or subsequent restoration:

GLO POST - NO EVIDENCE OF ORIGINAL CORNER FOUND

GLO ORIGINAL SURVEY PERFORMED BY JOSEPH FLETCHER UNDER CONTRACT DATED SEPT., 1816

PLATS

L. 40 P. 7	DANIEL SUBDIVISION	JULY 31, 1919
L. 40 P. 18	ED DE GRANDCHAMP GRATIOT FARM SUBDIVISION	AUGUST 16, 1919
L. 53 P. 5	EAST HAVEN SUBDIVISION	MARCH 9, 1925

95263087

STATE OF MICHIGAN MARTIN C. DUNN PROFESSIONAL SURVEYOR No. 30081 LICENSED PROFESSIONAL SURVEYOR

B. Description of corner evidence found and/or method applied in restoring or reestablishing corner:

M-2 T.1S, R.12E. COMMON TO A-2 T.1S.,R.13E.

NO EVIDENCE OF CORNER FOUND

HELD ALIGNMENT ESTABLISHED BY PROPERTY CORNERS ALONG THE SOUTH LINE OF STATE FAIR OFFSET AND EXTENDED LINE RECORD DISTANCES TO ESTABLISH SECTION CORNER

VERIFIED LOCATION WITH STONE CURB SPLITS AND SIDEWALK SPLITS.

FIELD MEASUREMENTS AND RECORDED DISTANCES

M-2 TO M-3 2640.45' (M.)

M-2 TO M-1 2645.19' (M.) 2646.20' (R.)

PLACED WAYNE COUNTY REMONUMENTATION MARKER AND ALUMINUM CAP #30081 ON 1/2" x 18" IRON WITHIN A MONUMENT BOX.

95 DEC -8 PM 2:11 FORREST E. YOUNGBLOOD REGISTER OF DEEDS WAYNE, MI

C. Description of monument for corner and accessories established to perpetuate locating the position of the corner:

M-2 T.1S, R.12E. WAYNE COUNTY REMONUMENTATION MARKER AND ALUMINUM CAP #30081 ON 1/2" x 18" ROD IN MONUMENT BOX.

WITNESSES

AZ. 40°	35.18'	SET PK NAIL AND W.C.R. TAG IN CONCRETE CURB
AZ. 124°	36.92'	SET PK NAIL AND W.C.R. TAG IN CONCRETE CURB
AZ. 219°	35.74'	SET PK NAIL AND W.C.R. TAG IN CONCRETE CURB
AZ. 314°	34.52'	SET PK NAIL AND W.C.R. TAG IN CONCRETE CURB

4
7D
MD

THE SELECTED LOCATION IS FOR THIS PROPERTY CONTROLLING MONUMENT IS ACCEPTED AS A CAREFUL AND FAITHFUL DETERMINATION OF THE POSITION INDICATED.

Signed by Martin C. Dunn Date DECEMBER 5, 1995

Surveyor's Michigan License No. 30081

FORM APPROVED BY MICHIGAN STATE BOARD OF LAND SURVEYORS, JAN. 28, 1971
REVISED MAY 14, 1975
REVISED JAN., 1993