

APR 05 1996

LAND CORNER RECORDATION CERTIFICATE
Filing Requirement of Act 74, Mich. P.A. 1970

For corners in **COMMISSION**
WAYNE

Located In: **HAMTRAMCK TWP
(NOW CITY OF DETROIT)**
Corner Code #

1. Public Land Survey	T	1S	R	12E	M-5
	T		R		
	T		R		
	T		R		
2. Property Controlling in Section	S	T	R		
	S	T	R		
3. Miscellaneous Property in Sec.	S	T	R		
	S	T	R		

Compliance with ACTS 45, P.A. 1990
APPROVED ON: **DEC 5 1995** *Yed.*
WAYNE COUNTY REMONUMENTATION
PEER GROUP COMMITTEE

Register of Deeds Stamp & File Number

4. Lot No. _____, Recorded Plat _____
5. Private Claims _____

A	B	C	D	E	F	G	H	I	J	K	L	M
2	8	5	4	3	2	1						
3												
4	7	8	9	10	11	12						
6												
6	18	17	16	15	14	13						
7												
8	19	20	21	22	23	24						
9												
10	30	29	28	27	26	25						
11												
12	31	32	33	34	35	36						

I, **MARTIN C. DUNN**, in a field survey on **OCTOBER 29, 19 95**, do hereby certify that under requirements of P.A. 74, Michigan P.A. of 1970, the corner points mentioned in lines 1 and 2 above were in conformance with regulations and rules therefore as required in the current manual of survey instructions of the United States Department of the Interior, Bureau of Land Management or by a decree of a Court of Law and for that the corner points mentioned in lines 3, 4 and 5 above were in conformance with the rules of the Michigan Board of Land Surveyors or by a Decree of a Court of Law; established, re-established, monumented, re-monumented, recovered; found as expressed below:

NOTE: Not more than 4 corners, all in the same town and range, may be recorded on this certificate.

A. Description of original monument and accessories and/or subsequent restoration:
GLO POST - NO EVIDENCE OF ORIGINAL CORNER FOUND

GLO ORIGINAL SURVEY PERFORMED BY JOSEPH FLETCHER UNDER CONTRACT DATED SEPT., 1816

PLATS

- L. 40 P. 48 HITCHMAN'S TAYLOR AVENUE SUBDIVISION
- L. 46 P. 22 DALBY-HAYES LAND COMPANY CRAFTS COMMUNE SUBDIVISION
- L. 48 P. 48 BARBER'S HOUSTON AVE. SUBDIVISION
- L. 59 P. 1 JOHN KELLY ESTATES SUBDIVISION
- L. 60 P. 31 DIEGEL HOMESTEAD PARK SUBDIVISION

- SEPTEMBER 20, 1919
- JULY 16, 1923
- MARCH 1, 1924
- FEBRUARY 11, 1926
- MAY 28, 1926


95 DEC -8 PM 2:41
FORESTER, YOUNGBLOOD
REGISTER OF DEEDS
WAYNE COUNTY, MI

B. Description of corner evidence found and/or method applied in restoring or reestablishing corner:
M-5 T.1S, R.12E. COMMON TO A-5 T.1S, R.13E.

**NO EVIDENCE OF EXISTING CORNER
HELD WALK SPLITS.
VERIFIED LOCATION WITH FOUND IRONS AND TIE TO ADJACENT SECTION CORNER.**

FIELD MEASUREMENTS AND RECORDED DISTANCES
M-5 TO M-4 2673.03' (M.) 2673.00' (R.)

PLACED WAYNE COUNTY REMONUMENTATION MARKER AND ALUMINUM CAP #30081 ON 1/2" x 18" IRON WITHIN A MONUMENT BOX.

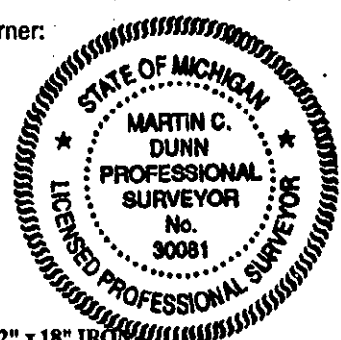

95263090

C. Description of monument for corner and accessories established to perpetuate locating the position of the corner:

M-5 T.1S., R.12E. WAYNE COUNTY REMONUMENTATION MARKER AND ALUMINUM CAP #30081 ON 1/2" x 18" ROD IN MONUMENT BOX.

WITNESSES:

- AZ. 55° 68.75' CITY OF DETROIT VERTICAL CONTROL MONUMENT
- AZ. 118° 69.68' SET PK WITH TAG IN NORTHEAST FACE OF UTILITY POLE
- AZ. 224° 35.03' SET PK WITH TAG IN NORTHWEST FACE OF UTILITY POLE
- AZ. 346° 99.73' SET PK WITH TAG IN SOUTHWEST FACE OF UTILITY POLE

4
7 D
7 R

THE SELECTED LOCATION IS FOR THIS PROPERTY CONTROLLING MONUMENT IS ACCEPTED AS A CAREFUL AND FAITHFUL DETERMINATION OF THE POSITION INDICATED.

Signed by Martin C. Dunn

Date **DECEMBER 5, 1995**

Surveyor's Michigan License No. **30081**