

SURVEY & REMONUMENTATION

APR 25 1995

RC 1489

COMMISSION

LAND CORNER RECORDATION CERTIFICATE
Filing Requirement of Act 74, Mich. P.A. 1970

L127797PA626

For corners in

WAYNE (County)	Located In: TOWNSHIP OF CANTON #07	Corner Code #
1. Public Land Survey	T <u>2S</u> R <u>8E</u>	C-13
	T _____ R _____	_____
	T _____ R _____	_____
	T _____ R _____	_____
2. Property Controlling in Section	S _____ T _____ R _____	_____
	S _____ T _____ R _____	_____
3. Miscellaneous Property in Sec.	S _____ T _____ R _____	_____
	S _____ T _____ R _____	_____

Compliance with ACT 345, P.A. 1990
APPROVED ON: 12-7-94 *DFJ*
WAYNE COUNTY REMONUMENTATION PEER GROUP COMMITTEE
Register of Deeds Stamp & File Number

- 4. Lot No. _____, Recorded Plat _____
- 5. Private Claims _____

I, E. PATRICK O'ROURKE, in a field survey on OCTOBER 27, 19 94, do hereby certify that under requirements of P.A. 74, Michigan P.A. of 1970, the corner points mentioned in lines 1 and 2 above were in conformance with regulations and rules therefore as required in the current manual of survey instructions of the United States Department of the Interior, Bureau of Land Management or by a decree of a Court of Law and/or that the corner points mentioned in lines 3, 4 and 5 above were in conformance with the rules of the Michigan Board of Land Surveyors or by a Decree of a Court of Law; established, re-established, monumented, re-monumented, recovered, found as expressed below:

NOTE: Not more than 4 corners, all in the same town and range, may be recorded on this certificate.

A. Description of original monument and accessories and/or subsequent restoration:

ORIGINAL GOVERNMENT SURVEY BY T. WAMPLER, D.S. (1815-1819)
G.L.O. (1816) DESCRIPTION OF CORNER NOT STATED IN NOTES
WITNESSES: ASH 16 N 34 W 4 (2.64' R) (GONE)
 HICKY 10 S 5 E 9 (5.94" R) (GONE)
RESURVEY AT THE DIRECTION OF ALBERT E. CHAMPNEY, DIRECTOR OF WAYNE COUNTY BUREAU OF TAXATION

(CONTINUED ON BACK)

B. Description of corner evidence found and/or method applied in restoring or reestablishing corner:

FOUND 1/2" IRON PIPE 10' +/- EAST OF EAST EDGE OF DENTON ROAD PAVEMENT.
DISTANCE TO B-13 MEASURED AS 2642.07'; RECORD WPA (1930) DISTANCE OF 2642.13'
DISTANCE TO D-13 MEASURED AS 2652.36'; RECORD WPA (1930) DISTANCE OF 2652.52'
L.19252 P.901 1/2" IRON PIPE
S 15° E 47.1' NORTHWEST CORNER HOUSE (MEASURED 46.98)
N 55° W 56.4' 24" WILLOW (GONE)
S 13° E 26.80' NAIL IN POWER POLE (MEASURED 26.80')
S 70° W 77.24' NAIL IN POWER POLE (MEASURED 77.12')


(CONTINUED ON BACK)

C. Description of monument for corner and accessories established to perpetuate locating the position of the corner:

C-13 SOUTHWEST CORNER SECTION 32, SOUTHEAST CORNER SECTION 31, T.2S., R.8E
SET CONCRETE MONUMENT WITH 3/8" IRON ROD 10' +/- EAST OF EAST EDGE OF DENTON ROAD PAVEMENT AT ROAD ELEVATION, AND IT IS ACCEPTED AS A CAREFUL AND FAITHFUL PERPETUATION OF THE POSITION OF THE ORIGINAL CORNER.
WITNESSES: S 15° E 46.98' NORTHWEST CORNER HOUSE (PREVIOUSLY USED)
 S 13° E 26.80' NAIL/SHINER WEST SIDE POWER POLE (PREVIOUSLY USED)
 S 70° W 77.12' NAIL/SHINER NORTH SIDE POWER POLE (PREVIOUSLY USED)
 N 45° W 99.36' NAIL/SHINER EAST SIDE MULTI-STEMMED 6" TREE
 WEST 37.47' PK NAIL/SHINER IN WEST EDGE ASPHALT PAVEMENT

	A	B	C	D	E	F	G	H	I	J	K	L	M
2	6		5		4		3		2		1		
3													
4	7		8		9		10		11		12		
5													
6	16		17		16		15		14		13		
7													
8	19		20		21		22		23		24		
9													
10	30		29		28		27		26		25		
11													
12	31		32		33		34		35		36		
13													

\$ 16.00 MISCELLANEOUS RECORDING
27 DEC 94 11:01 A.M. RECEIPT# 48A
RECORDED
FOREST E. YOUNGBLOOD, REGISTER OF DEEDS
WAYNE COUNTY, MI

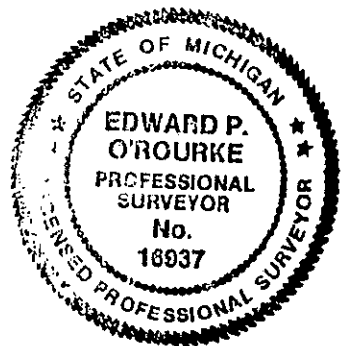

Signed by *E. Patrick O'Rourke*
E. PATRICK O'ROURKE
Surveyor's Michigan License No. 1603

Date 12-27-94

L127797PA627

SECTION A (CONTINUED)

WPA (1930s) IRON SET SW 32 #167

WITNESSES: SE 26.00' EDISON POLE (MEASURED 26.80)
SOUTH 31.00' 10" MAPLE (GONE)
SW 68.70' TELEPHONE POLE (GONE)
WEST 37.60' MONUMENT (MEASURED 37.47' TO PK AND SHINER)

W.C.R.C. IRON SW 32 #167

WITNESSES: SE 26.77' DETROIT EDISON POLE (MEASURED 26.80)
SW 77.22' DETROIT EDISON POLE (MEASURED 77.12)
W 37.60' NORTHWEST 5 VAN BUREN IRON (MEASURED 37.47 PK/SHINER)
NW 57.26' 30" TREE (GONE)

SECTION B (CONTINUED)

L.18920 P.503 1/2" IRON PIPE

S 15° E 47.1' NORTHWEST CORNER OF HOUSE (MEASURED 46.98)
N 55° W 56.4' 24" WILLOW (GONE)
S 13° E 26.80' NAIL IN POWER POLE (MEASURED 26.80')
S 70° W 77.24' NAIL IN POWER POLE (MEASURED 77.12')

NO OTHER L.C.R.C. ON RECORD AT WAYNE COUNTY REGISTER OF DEEDS.