For corners in					
WAYNE (County)		-	Located in: TOWNSHIP OF CANTON		Corner Code # (#07)
1.	Public Land Survey		T <u>2S</u> T T T	R <u>8E</u> .R .R	H-7
2.	Property Controlling in Section	S	TT	R	
3.	Miscellaneous Property in Sec.	S S	T	R	
4. 5.	Lot No Private Claims				
					•

I, WALTER J. ZBIKOWSKI, in a field survey on OCTOBER 14, 19.96, do hereby certify that under requirements of P.A. 74, Michigan P.A. of 1970, the corner points mentioned in lines 1 and 2 above were in conformance with regulations and rules therefore as required in the current manual of survey instructions of the United States Department of the Interior, Bureau of Land Management or by a decree of a Court of Law and/or that the corner points mentioned in lines 3, 4 and 5 above were in conformance with the rules of the Michigan Board of Land Surveyors or by a Decree of a Court of Law; established, re-established, monumented, remonumented, recovered, found as expressed below.

Not more than 4 corners, all in the same town and range, may be recorded on this certificate.

Description of original monument and accessories and/or subsequent restoration. ORIGINAL GOVERNMENT SURVEY BY T. WAMPLER, D.S. (1815-1819)

G.L.O. (1819) WEST, CORRECTED BETN S. 15 & 22, 39.92-1/2 (CHAINS), SET 1/4 S. POST AT AVER DIST.

(DESCRIPTION OF CORNER NOT STATED IN NOTES)

LYNN 5" N 33 E 9 (LINKS) (5.94') (GONE) WITNESSES:

30" N 25 W 25 (LINKS) (16.50') (GONE) **ELM** 

RESURVEY AT THE DIRECTION OF ALBERT E. CHAMPNEY, DIRECTOR OF WAYNE COUNTY HUNG

W.P.A, (1930's), IRON, N-22 (#84) WITNESSES: 32.05 NE

SE 26.30 SW 62.83 WNW 105.28 CROSS IN STONE 9's OF FENCE COR (GONE) WAYNE COUNTY ROAD SIGN (GONE) CROSS IN STONE IN FENCE LINE (GONE)

TELEPHONE POLE (GONE)

FOREST E. YOUNGBLOOD, REGISTER OF DE WAYNE COUNTY, MI

\$ 4.00 REMONUMENTATION

Description of corner evidence found and/or method applied in restoring or reestablishing corner.

FOUND A 3/8" REBAR IN A ROAD BOX (GOOD, WITHOUT LID) AT THE INTERSECTION OF SHELDON ROAD (A TWO AND FOUR LAN ASPHALT (S) AND CONCRETE (N) PAVEMENT) AND CHERRY HILL ROAD (A TWO AND FOUR LANE ASPHALT ROAD). DISTANCE TO H-6 MEASURED AS 2633.43'; W.P.A. (1930's) RECORD DISTANCE OF 2633.11';

DISTANCE TO I-7 MEASURED AS 2651.43'; G.L.O. (1819) RECORD DISTANCE OF 39.92-1/2 CHAINS (2635.05'); W.P.A. (1930's) RECOF

**DISTANCE OF 2652.29';** DISTANCE TO H-8 (CENTER OF ROAD BOX) MEASURED AS 2649.62'; W.P.A. (1930's) RECORD DISTANCE OF 2650.08'; DISTANCE TO G-7 MEASURED AS 2634.66'; G.L.O. (1819) RECORD DISTANCE OF 39.92-1/2 CHAINS (2635.05'); W.P.A. (1930)

**DISTANCE OF 2633.66';** L.18836 PG. 325-326, FOUND MONUMENT IN HANDHOLE (1974) RC #337

WITNESSES:

N.75°26'00"E. S.41°14'00"E. 117.61 78.65

NAIL IN SE SIDE OF 20" ELM (GONE)

NAIL'IN NE SIDE (WITH PLAIN BRASS DISC) OF DETROIT EDISON POLE

(MEASURED 78.621)

S.66°38'00"W. 106.38

NAIL IN NW SIDE OF DETROIT EDISON POLE (TO BE REMOVED) (MEASURE

106.381)

N.30°20'00"W. 35.63 FACE OF STOP SIGN (GONE)

## (CONTINUED ON BACK)

Description of monument for corner and accessories established to perpetuate locating the position of the corner.

H-7 SECTION CORNER 15, 22 T.2S., R.8E. PLACED A REMONUMENTATION BRASS DISC AND PVC CAP #21586 ON 3/8" REBAR IN A ROAD BOX AT THE INTERSECTION C SHELDON ROAD (A TWO LANE AND FOUR LANE ASPHALT (S) AND CONCRETE (N) PAVEMENT) AND CHERRY HILL ROAD (A TW LANE AND FOUR LANE ASPHALT ROAD) AND IT IS ACCEPTED AS A CAREFUL AND FAITHFUL PERPETUATION OF THE POSITIC OF THE ORIGINAL CORNER.

WITNESSES:

Signed by **W** 

N.46°07'E. 71.27

S.42°05'E. 78.51

FOUND A W.C.R.C. REFERENCE NAIL IN BRASS DISC ON SE SIDE OF DETROIT EDISON POI

FOUND A NAIL IN G.W. ALUMINUM DISC ON NE SIDE OF DETROIT EDISON POLE FOUND A W.C.R.C. REFERENCE NAIL IN BRASS DISC ON NW SIDE OF UTILITY POLE SET NAIL IN W.C.R. BRASS WITNESS DISC ON NE SIDE OF UTILITY POLE

S.31°09'W. 69.15 N.30°09',W. 58.80

<u>likwek</u>i

WALTER J. ZBIKOWSKI Survevor's Michigan License No.


21586

Compliance with ACT 345, P.A. 1990

LIBER 29337 PAGE

11-13-96 APPROVED ON: WAYNE COUNTY REMONUMENTATION PEER GROUP COMMITTEE

Register of Deeds Stamp & File Number

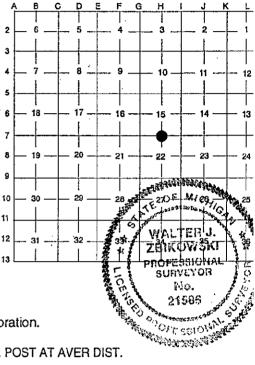

RECORDED

F TAXATIONECEIPT# 62

## CONTINUED

.:.

L.20053 P. 705, 1/2", IRON PIPE IN MONUMENT BOX (1977) CS #1452
WITNESSES: N.45°E. 71.50' PK NAIL SE/S (NW/S) DETROIT EDISON POLE (MEASURED 71.34')
S.53°E. 67.84' "X" ON N/RIM OF MICHIGAN BELL TELEPHONE MANHOLE (MEASURED 67.83')
S.42°W. 61.17' "X" ON N/RIM OF MICHIGAN BELL TELEPHONE MANHOLE (MEASURED 67.20')
N.23°W. 68.90' "X" ON S/RIM OF G.V. & W. (MEASURED 68.92')

FILE DO NOT MAIL