

LAND CORNER RECORDATION CERTIFICATE
Filing Requirement of Act 74, Mich. P.A. 1970

For corners in


<u>WAYNE</u> (County)	Located in: TOWNSHIP OF CANTON (#07)	Corner Code # _____
1. Public Land Survey	T <u>2S</u> R <u>8E</u>	<u>I-3</u>
	T _____ R _____	_____
	T _____ R _____	_____
	T _____ R _____	_____
2. Property Controlling in Section	S _____ T _____ R _____	_____
	S _____ T _____ R _____	_____
3. Miscellaneous Property in Sec.	S _____ T _____ R _____	_____
	S _____ T _____ R _____	_____
4. Lot No. _____, Recorded Plat _____		
5. Private Claims _____		

LIBER **29337** PAGE **556**

Compliance with
ACT 345, P.A. 1990
APPROVED ON: 11-13-96
WAYNE COUNTY REMONUMENTATION
PEER GROUP COMMITTEE

Register of Deeds Stamp & File Number

A	B	C	D	E	F	G	H	I	J	K	L
2	6		5		4		3		2		1
3								●			
4	7		8		9		10		11		12
5											
6	18		17		16		15		14		13
7											
8	19		20		21		22		23		24
9											
10	30		29		28		27		26		25
11											
12	31		32		33		34		35		36
13											

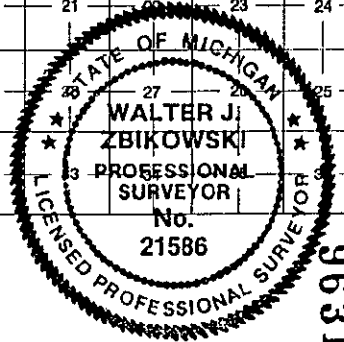

I, WALTER J. ZBIKOWSKI, in a field survey on OCTOBER 14, 1996, do hereby certify that under requirements of P.A. 74, Michigan P.A. of 1970, the corner points mentioned in lines 1 and 2 above were in conformance with regulations and rules therefore as required in the current manual of survey instructions of the United States Department of the Interior, Bureau of Land Management or by a decree of a Court of Law and/or that the corner points mentioned in lines 3, 4 and 5 above were in conformance with the rules of the Michigan Board of Land Surveyors or by a Decree of a Court of Law; established, re-established, monumented, re-monumented, recovered, found as expressed below.

NOTE: Not more than 4 corners, all in the same town and range, may be recorded on this certificate.

A. Description of original monument and accessories and/or subsequent restoration.
ORIGINAL GOVERNMENT SURVEY BY T. WAMPLER, D.S. (1815-1819)
 G.L.O. (1819) SET POST COR. S. 2, 3, 10, & 11, NORTH 80.00 CHAINS (DESCRIPTION OF CORNER NOT STATED IN NOTES)
 WITNESSES: BEECH 10" N 21-1/2 E 24 (LINKS) (15.84') (GONE)
 ASH 7" S 18 W 16 (LINKS) (10.56') (GONE)
RESURVEY AT THE DIRECTION OF ALBERT E. CHAMPNEY, DIRECTOR OF WAYNE COUNTY BUREAU OF TAXATION
 W.P.A. (1930's) IRON SET OVER STONE, NW-11 (#31) **12 DEC 96 2:14 P.M. RECEIPT# 62B**
 WITNESSES: N 34.37' FENCE POST (GONE) **RECORDED**
 SE 44.60' CROSS IN W. COR DOOR SILL (GONE) **FOREST E. YOUNGBLOOD, REGISTER OF DEEDS**
 SW 83.59' MON. (GONE) **WAYNE COUNTY, MI**
 NW 71.28' 3" DEAD ELM (GONE) **\$ 4.00 REMONUMENTATION**

B. Description of corner evidence found and/or method applied in restoring or reestablishing corner.
 FOUND A 3/8" REBAR IN A ROAD BOX (GOOD) AT THE INTERSECTION OF WARREN ROAD (A TWO LANE ASPHALT ROAD) AND MORTON TAYLOR ROAD (A FIVE LANE CONCRETE PAVEMENT TO NORTH ONLY).
 DISTANCE TO I-2 MEASURED AS 2659.49'; G.L.O. (1819) RECORD DISTANCE OF 40.00 CHAINS (2640.00'); W.P.A. (1930's) RECORD DISTANCES OF 2658.90' AND 2658.34';
 L.93 PG.46-48, "WINDSOR PARK SUBDIVISION NO. 3" RECORD DISTANCE OF 2658.88';
 DISTANCE TO J-3 MEASURED AS 2633.40'; G.L.O. (1819) RECORD DISTANCE OF 39.75 CHAINS (2623.50'); W.P.A. (1930's) RECORD DISTANCES OF 2633.34' AND 2633.34';
 DISTANCE TO H-3 MEASURED AS 2646.61'; G.L.O. (1819) RECORD DISTANCE OF 39.75 CHAINS (2623.50'); W.P.A. (1930's) RECORD DISTANCES OF 2646.31' AND 2646.60';
 L.17788 PG. 10-11, FOUND BOAT SPIKE (1971) RC #4
 WITNESSES: N.61°50'E. 111.21' PK NAIL WITH FLASHER NW FACE DETROIT EDISON POLE (MEASURED 111.05')
 S.42°00'E. 59.45' CROSS (GONE) IN NORTH RIM GATE VALVE/MANHOLE (MEASURED 59.22 ±)
 (EXPLANATION: FOUND CROSS ON EAST RIM GATE VALVE MANHOLE - MEASURED 60.72')
 S.67°40'W. 63.38' PK NAIL WITH FLASHER SE FACE MICHIGAN BELL TELEPHONE POLE (GONE)
 N.43°50'W. 74.84' PK NAIL WITH FLASHER NE FACE OF DETROIT EDISON POLE (MEASURED 75.10')

(CONTINUED ON BACK)

C. Description of monument for corner and accessories established to perpetuate locating the position of the corner.
 I-3, SECTION CORNER 2, 3, 10, AND 11, T.2S., R.8E.
 PLACED A REMONUMENTATION BRASS DISC AND PVC CAP #21586 ON 3/8" REBAR IN A ROAD BOX AT THE INTERSECTION OF WARREN ROAD (A TWO LANE ASPHALT ROAD) AND MORTON TAYLOR ROAD (A FIVE LANE CONCRETE PAVEMENT TO THE NORTH ONLY) AND IT IS ACCEPTED AS A CAREFUL AND FAITHFUL PERPETUATION OF THE POSITION OF THE ORIGINAL CORNER.
 WITNESSES: N.44°57'E. 74.06' FOUND A PK NAIL IN W.C.R.C. BRASS REFERENCE DISC ON SE SIDE OF A UTILITY POLE
 S.42°39'E. 77.98' FOUND A PK NAIL IN W.C.R.C. BRASS REFERENCE DISC ON SW SIDE OF A UTILITY POLE
 S.39°27'W. 79.22' FOUND A PK NAIL ON SE SIDE OF 6" FIBER OPTIC WOOD MARKER POLE
 N.43°28'W. 75-10' FOUND A PK NAIL IN PLAIN DISC ON NE SIDE OF A UTILITY POLE (SUPRA)

Signed by Walter J. Zbikowski Date DEC. 11, 1996
 Surveyor's Michigan License No. 21586

412
100
M

B. CONTINUED

L.18309, P.735, FOUND 1/2" IRON BAR IN WARREN ROAD (1972) RC #183

LIBER 29337 PAGE 557

WITNESSES: N.55°E. 110.99' PK NAIL WITH FLASHER IN NW SIDE OF UTILITY POLE (MEASURED 111.05')
S.50°E. 59.35' CHISELED "X" (GONE) ON N. RIM OF SANITARY MANHOLE (GV&W) (SEE EXPLANATION ABOVE)
S.50°W. 63.75' PK NAIL WITH FLASHER IN SE SIDE OF UTILITY POLE (GONE)
N.60°W. 75.16' PK NAIL WITH FLASHER IN NE SIDE OF UTILITY POLE (MEASURED 75.10')

FILE DO NOT MAIL