

APR 05 1996

LAND CORNER RECORDATION CERTIFICATE
Filing Requirement of Act 74, Mich. P.A. 1979

4.00 REMONUMENTATION
10.00 DEED
7 DEC 95 11:06 A.M. RECEIPT

For corners in COMMISSION

RECORDED
FOREST E. YOUNGBLOOD, REGISTER
WAYNE COUNTY, MI

WAYNE Located in: Corner Code #
(County) TOWNSHIP OF CANTON #07

1. Public Land Survey	T2S	R8E	J-3
	T	R	
	T	R	
	T	R	
2. Property Controlling in Section	S	T	R
	S	T	R
3. Miscellaneous Property in Sec.	S	T	R
	S	T	R
4. Lot No. _____, Recorded Plat _____			
5. Private Claims _____			

Compliance with ACT 345, P.A. 1990
APPROVED ON: 12-4-95
WAYNE COUNTY REMONUMENTATION PEER GROUP COMMITTEE

Register of Deeds Stamp & File Number

A	B	C	D	E	F	G	H	I	J	K	L	M
2	6		6		4		3		2		1	
3									●			
4	7		8		9		10		11		12	
5												
6	18		17		16		15		14		13	
7												
8	19		20		21		22		23		24	
9												
10	30		29		28		27		26		25	
11												
12	31		32		33		34		35		36	
13												

I, WALTER J. ZBIKOWSKI, in a field survey on SEPTEMBER 19, 1995, do hereby certify that under requirements of P.A. 75, Michigan P.A. of 1970, the corner points mentioned in lines 1 and 2 above were in conformance with regulations and rules therefore as required in the current manual of survey instructions of the United States Department of the Interior, Bureau of Land Management or by a decree of a Court of Law and/or that the corner points mentioned in lines 3, 4 and 5 above were in conformance with the rules of the Michigan Board of Land Surveyors or by a Decree of a Court of Law; established, re-established, monumented, re-monumented, recovered, found as expressed below.

NOTE: Not more than 4 corners, all in the same town and range, may be recorded on this certificate.

A. Description of original monument and accessories and/or subsequent restoration.
ORIGINAL GOVERNMENT SURVEY BY T. WAMPLER, D.S. (1815-1819)
G.L.O. (1819) SET 1/4 S. POST (DESCRIPTION OF CORNER NOT STATED IN NOTES)
WITNESSES: SUGAR 5 S 57 W 10 (6.60' REC) (GONE)
IRON'D 8 N 56 E 14 (9.24' REC) (GONE)

RESURVEY AT THE DIRECTION OF ALBERT E. CHAMPNEY, DIRECTOR OF WAYNE COUNTY BUREAU OF TAXATION

(CONTINUED ON BACK)

B. Description of corner evidence found and/or method applied in restoring or reestablishing corner.
FOUND 5/8" REBAR IN ROAD BOX (GOOD) AT INTERSECTION OF CONCRETE PAVEMENT OF WARREN AND LILLEY ROADS.
DISTANCE TO K-3 TRAVERSED AS 2616.85'; RECORD G.L.O. (1819) DISTANCE OF 39.25 CHAINS (2590.50') RECORD
W.P.A. (1930s) DISTANCES OF 2617.32' AND 2617.61'
DISTANCE TO J-2 MEASURED AS 2659.89'; RECORD W.P.A. (1930s) DISTANCE OF 2660.59'
DISTANCE TO I-3 MEASURED AS 2633.40'; RECORD G.L.O. (1819) DISTANCE OF 39.25 CHAINS (2590.50') RECORD
W.P.A. (1930s) DISTANCES OF 2333.44' AND 2633.34'

L.18128 P.378 IRON IN MONUMENT BOX (1971) LCRC #96

NW 41.90' W.C.R.C. ROAD SIGN (GONE)
NE 57.84' NAIL AND CAP WEST SIDE MICHIGAN BELL TELEPHONE POLE (GONE)
SE 60.85' NAIL AND CAP WEST SIDE MICHIGAN BELL TELEPHONE POLE (GONE)


(CONTINUED ON BACK)

C. Description of monument for corner and accessories established to perpetuate locating the position of the corner.
J-3 SECTION CORNER 2, 11 T.2S., R.8E
A 5/8" REBAR IN A GOOD ROAD BOX IN CONCRETE PAVEMENT AT THE INTERSECTION OF WARREN AND LILLEY ROADS, AND
IT IS ACCEPTED AS A CAREFUL AND FAITHFUL PERPETUATION OF THE POSITION OF THE ORIGINAL CORNER.
WITNESSES: S.22°51'E. 82.37' CENTER OF TOP BOLT OF HYDRANT (SUPRA)
S.33°01'E. 78.37' SET NAIL IN W.C.R. WITNESS BRASS TAG ON NORTHEAST SIDE OF TRAFFIC LIGHT GUY POLE
S.36°37'W. 79.26' PK NAIL IN W.C.R.C. REFERENCE BRASS DISC HIGH SOUTHEAST SIDE OF DETROIT EDISON POLE (SUPRA)
N.43°56'W. 69.08' PLAIN PK NAIL IN NORTHEAST SIDE OF DETROIT EDISON POLE (SUPRA)

PLACED A REMONUMENTATION BRASS DISC ON ABOVE FOUND 5/8" REBAR J-3.

Signed by Walter J. Zbikowski
WALTER J. ZBIKOWSKI
Surveyor's Michigan License No. 71536

Date DEC. 6, 1995

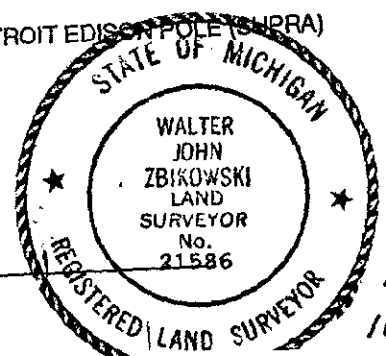

95261586

4
10,

SECTION A (CONTINUED)

LIBER 28448 PAGE 897

W.P.A. (1930s) MONUMENT N-11 (#30)

WITNESSES:	NE	56.39'	(NAIL NORTHWEST SIDE) TELEPHONE POLE (GONE)
	ESE	57.77'	MONUMENT (GONE)
	SE	60.90'	(NAIL SOUTHWEST SIDE) TELEPHONE POLE (GONE)
	SSW	52.30'	(NAIL NORTHWEST SIDE) 18" MAPLE (GONE)
	NW	64.00'	(NAIL SOUTH SIDE) EDISON POLE (GONE)
	NW	57.67'	MONUMENT (GONE)

W.C.R.C. (1970) IRON N-11 (#30)

	NE	57.75'	(NAIL NORTHWEST SIDE) MICHIGAN BELL TELEPHONE POLE (GONE)
	SE	60.77'	(NAIL SOUTHWEST SIDE) MICHIGAN BELL TELEPHONE POLE (GONE)
	SSE	82.49'	TOP OF HYDRANT (MEASURED 82.37')
	SW	53.20'	(NAIL SOUTHEAST SIDE) DETROIT EDISON POLE (GONE)

SECTION B (CONTINUED)

L.18134 P.605-606

	3/8" ROD IN HANDHOLE (1972) LCRC #101
N.25°00'E.	58.19' SPIKE IN CAP NORTHWEST SIDE MICHIGAN BELL TELEPHONE POLE (GONE)
S.22°00'E.	60.27' PK NAIL NORTH SIDE MICHIGAN BELL TELEPHONE POLE (GONE)
S.60°00'W.	53.12' SPIKE IN CAP SOUTHEAST SIDE DETROIT EDISON POLE (GONE)
N.45°00'W. 69.17'	PK NAIL (PLAIN) NORTHEAST SIDE DETROIT EDISON POLE (MEASURED 69.08')

L.27333 P.774 IRON IN BOX (1994) LCRC #1386

N.36°E.	67.00'	NAIL (IN PLAIN CAP NORTHWEST SIDE) IN DETROIT EDISON POLE (MEASURED 66.93')
S.40°E.	78.33'	(PK) NAIL (IN PLAIN CAP EAST SIDE) IN DETROIT EDISON POLE (MEASURED 78.52')
S.45°E.	82.43'	CENTER (OF TOP BOLT) OF HYDRANT (MEASURED 82.37')
S.37°W.	79.26'	(PK) NAIL (IN W.C.R.C. REFERENCE BRASS DISC HIGH SOUTHEAST SIDE) IN DETROIT EDISON POLE (MEASURED 79.26')
N.45°W.	69.15'	(PK) NAIL (PLAIN ON NORTHEAST SIDE) IN DETROIT EDISON POLE (MEASURED 69.08')

L.18650 P.769-770

	3/8" ROD (1973) CS #765	
NE	58.20'	PK NAIL (HIGH) IN NORTHWEST FACE OF MICHIGAN BELL TELEPHONE (GONE)
SE	64.34'	PK NAIL EAST SIDE OF MICHIGAN BELL TELEPHONE POLE (GONE)
SW	79.50'	PK NAIL (PLAIN) IN SOUTHEAST SIDE OF DETROIT EDISON POLE (MEASURED 79.42')
NW	69.39'	PK NAIL (PLAIN) IN SOUTHEAST (NORTHEAST) FACE OF DETROIT EDISON POLE (MEASURED 69.08')

L.P. (UNKNOWN)

3/8" ROD IN HANDHOLE (1974) CS #947

SAME WITNESSES AS L.18134 P.605-606 (1972) LCRC #101 ABOVE.