

**SURVEY & REMONUMENTATION**

**LAND CORNER RECORDATION CERTIFICATE**  
Filing Requirement of Act 74, Mich. P.A. 1970

APR 05 1996

\$ 4.00 REMONUMENTATION

\$ 10.00 DEED

DEC 95 11:07 A.M.

RECEIP

RECORDED

FOREST E. YOUNGBLOOD, REGISTER  
WAYNE COUNTY, MI

EDS

For corners in

**COMMISSION**

WAYNE

(County)

1. Public Land Survey

Located in: Corner Code #  
TOWNSHIP OF CANTON #07

T2S R8E J-9

T R

T R

T R

2. Property Controlling in Section

S T R

S T R

3. Miscellaneous Property in Sec.

S T R

S T R

4. Lot No. \_\_\_\_\_ Recorded Plat \_\_\_\_\_

5. Private Claims \_\_\_\_\_

LIBER 28448 PAGE 898

Compliance with  
ACT 345, P.A. 1990

APPROVED ON: 12-4-95  
WAYNE COUNTY REMONUMENTATION  
PEER GROUP COMMITTEE

Register of Deeds Stamp & File Number

I, WALTER J. ZBIKOWSKI, in a field survey on SEPTEMBER 25, 1995, do hereby certify that under requirements of P.A. 75, Michigan P.A. of 1970, the corner points mentioned in lines 1 and 2 above were in conformance with regulations and rules therefore as required in the current manual of survey instructions of the United States Department of the Interior, Bureau of Land Management or by a decree of a Court of Law and/or that the corner points mentioned in lines 3, 4 and 5 above were in conformance with the rules of the Michigan Board of Land Surveyors or by a Decree of a Court of Law; established, re-established, monumented, re-monumented, recovered, found as expressed below.

NOTE: Not more than 4 corners, all in the same town and range, may be recorded on this certificate.

A	B	C	D	E	F	G	H	I	J	K	L	M
2	8		5		4		3		2		1	
3												
4	7		6		9		10		11		12	
5												
6	18		17		16		15		14		13	
7												
8	19		20		21		22		23		24	
9												
10	30		28		28		27		25		25	
11												
12	31		32		33		34		35		36	
13												

A. Description of original monument and accessories and/or subsequent restoration.  
ORIGINAL GOVERNMENT SURVEY BY T. WAMPLER, D.S. (1815-1819)  
G.L.O. (1819) SET 1/4 S POST AT AVER DIST (DESCRIPTION OF CORNER NOT STATED IN NOTES)  
WITNESSES BEECH 12 S 21 W 6 (3.96' REC) (GONE)  
DO 28 N 30 W 26 (17.16' REC) (GONE)

RESURVEY AT THE DIRECTION OF ALBERT E. CHAMPNEY, DIRECTOR OF WAYNE COUNTY BUREAU OF TAXATION  
W.P.A. (1930s) CROSS IN STONE HIGH POINT 1.0 DEEP N-26 (#108)  
WITNESSES: NE 50.44' 22" MAPLE (GONE)  
SE 33.17' TWIN ASH (GONE)  
SW 21.50' TWIN ELM (GONE)

W.C.R.C. (1970) IRON N-26 (#108)  
WITNESSES: NE 54.91' ROAD SIGN (GONE)  
SE 47.27' DETROIT EDISON POLE (GONE)  
SW 39.70' GUY POLE (GONE)  
NW 57.98' DETROIT EDISON POLE (GONE)

B. Description of corner evidence found and/or method applied in restoring or reestablishing corner.

FOUND A 1/2" IRON PIPE WITH PVC CAP #21561 IN A ROAD BOX (GOOD) AT THE SOUTH EDGE OF EAST BOUND PALMER AND WEST EDGE OF SOUTH BOUND LILLEY ROADS (BOTH ASPHALT SURFACED 2, 3 LANE ROADS).  
DISTANCE TO K-9 MEASURED AS 2579.08'; RECORD G.L.O. (1819) DISTANCE OF 39.06 CHAINS (2577.96'); RECORD W.P.A. (1930s) DISTANCES OF 2578.60' AND 2578.75'  
DISTANCE TO I-9 MEASURED AS 2594.69'; RECORD G.L.O. (1819) DISTANCE OF 39.06 CHAINS (2577.96'); RECORD W.P.A. (1930s) DISTANCES OF 2594.73' AND 2594.97'  
DISTANCE TO J-10 MEASURED AS 2640.36'; RECORD W.P.A. (1930s) DISTANCE OF 2639.07'

(CONTINUED ON BACK)


C. Description of monument for corner and accessories established to perpetuate locating the position of the corner.

I-9 SECTION CORNER 23, 26 T.2S., R.8E.  
A 1/2" IRON PIPE WITH PVC CAP #21561 IN A ROAD BOX (GOOD) AT THE SOUTH EDGE OF EAST BOUND PALMER AND WEST EDGE OF LILLEY ROADS (BOTH ASPHALT 2, 3 LANE ROADS, RESPECTIVELY) AND IT IS ACCEPTED AS A CAREFUL AND FAITHFUL PERPETUATION OF THE POSITION OF THE ORIGINAL CORNER.  
WITNESSES: N.58°56'E. 102.40' FOUND PK NAIL IN ALUMINUM DISC #34970 ON NORTHWEST SIDE OF UTILITY POLE  
S.43°07'E. 95.09' CENTER OF TOP NUT OF FIRE HYDRANT (SUPRA)  
S.36°59'W. 35.24' FOUND PK NAIL (PLAIN) ON NORTHWEST SIDE OF UTILITY POLE (SUPRA)  
N.64°03'W. 120.76' FOUND PK NAIL (PLAIN) ON NORTHEAST SIDE OF UTILITY POLE (SUPRA)

PLACED A REMONUMENTATION BRASS DISC AND PVC CAP #21586 ON ABOVE FOUND 1/2" IRON PIPE J-9.

Signed by Walter J. Zbikowski  
WALTER J. ZBIKOWSKI  
Surveyor's Michigan License No. 21586

Date Dec. 6, 1995

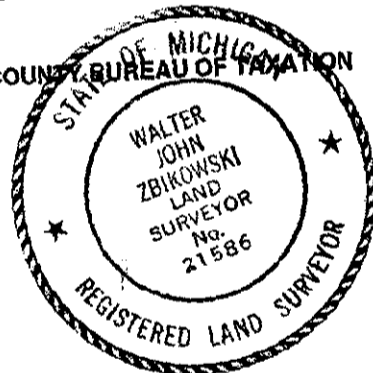

95261587

4

B. CONTINUED

- L. 18641 P. 640 5/8" IRON PIPE (1973) CS #761
  - NE 97.24' PK (NORTHWEST SIDE) MICHIGAN BELL TELEPHONE POLE (GONE)
  - E 65.44' 5/8" IRON PIPE (BURIED UNDER ASPHALT ROAD)
  - SE 47.71' PK (SOUTHWEST SIDE) MICHIGAN BELL TELEPHONE POLE (GONE)
  - SW 39.73' PK (SOUTHEAST SIDE) GUY POLE (GONE)

- L. 18598 P. 147-148 SET 5/8" IRON PIPE (1973) LCRC #264
  - N.64°42'10"E. 99.22' PK NAIL IN NW SIDE MICHIGAN BELL TELEPHONE POLE (GONE)
  - N.89°48'10"E. 66.41' FOUND 5/8" IRON PIPE (BURIED UNDER ASPHALT ROAD)
  - S.30°21'50"E. 47.70' PK NAIL IN NE SIDE DETROIT EDISON POLE (GONE)
  - S.45°26'10"W. 39.70' PK NAIL IN SE SIDE GUY POLE (GONE)
- L. 26633 P. 148 FOUND IRON PIPE RLS#21561 IN MON. BOX (1992) LCRC #1077
  - N.50°E. 88.78' FOUND PK NAIL IN NW FACE OF UTILITY POLE (GONE)
  - S.35°E. 47.68' FOUND PK NAIL IN NE FACE OF UTILITY POLE (GONE)
  - S.45°W. 39.70' FOUND PK NAIL IN SE FACE OF UTILITY POLE (GONE)
  - N.60°W. 120.75' FOUND PK NAIL IN NE FACE OF UTILITY POLE (MEASURED 120.76')
- L. 26750 P. 633 (COULD NOT READ DESCRIPTION) (1973) LCRC #1082
  - S.40°W. 35.33' PK NAIL NW SIDE OF UTILITY POLE (MEASURED 35.24')
  - S.43°E. 95.06' TOP NUT OF FIRE HYDRANT (MEASURED 95.09')
  - N.54°W. 99.96' NE CORNER OF CONCRETE RAMP (GONE)
  - N.04°W. 59.02' NW CORNER OF SIDEWALK INTERSECTION (MEASURED 59.03')