

LAND CORNER RECORDATION CERTIFICATE
Filing Requirement of Act 74, Mich. P.A. 1970

For corners in

<u>WAYNE</u> (County)	Located in: TOWNSHIP OF CANTON (#07)	Corner Code # J-11
1. Public Land Survey	T <u>2S</u> R <u>8E</u>	<u>J-11</u>
	T _____ R _____	_____
	T _____ R _____	_____
2. Property Controlling in Section	S _____ T _____ R _____	_____
	S _____ T _____ R _____	_____
3. Miscellaneous Property in Sec.	S _____ T _____ R _____	_____
	S _____ T _____ R _____	_____
4. Lot No. _____, Recorded Plat _____		
5. Private Claims _____		


LIBER **29337** PAGE **569**

Compliance with
ACT 345, P.A. 1990

APPROVED ON: 11-13-96
WAYNE COUNTY REMONUMENTATION
PEER GROUP COMMITTEE

Register of Deeds Stamp & File Number

A	B	C	D	E	F	G	H	I	J	K	L	M
2	6		5		4		3		2		1	
3												
4	7		8		9		10		11		12	
5												
6	18		17		16		15		14		13	
7												
8	19						22		23		24	
9												
10	20								26		25	
11												
12									35		36	
13												

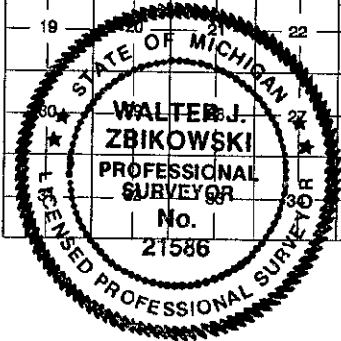

96319308

I, WALTER J. ZBIKOWSKI, in a field survey on OCTOBER 14, 1996, do hereby certify that under requirements of P.A. 74, Michigan P.A. of 1970, the corner points mentioned in lines 1 and 2 above were in conformance with regulations and rules therefore as required in the current manual of survey instructions of the United States Department of the Interior, Bureau of Land Management or by a decree of a Court of Law and/or that the corner points mentioned in lines 3, 4 and 5 above were in conformance with the rules of the Michigan Board of Land Surveyors or by a Decree of a Court of Law; established, re-established, monumented, re-monumented, recovered, found as expressed below.

NOTE: Not more than 4 corners, all in the same town and range, may be recorded on this certificate.

A. Description of original monument and accessories and/or subsequent restoration.
ORIGINAL GOVERNMENT SURVEY BY T. WAMPLER, D.S. (1815-1819)
 G.L.O. (1819), WEST 39.30 CHAINS, SET TEM 1/4 S. POST AT AV DIST (DESCRIPTION OF CORNER NOT STATED IN NOTES)
 WITNESSES: R.O. 8" N 21 E 13 (LINKS) (8.58') (GONE)
 SUGAR 18" S 8 E 29 (LINKS) (19.14') (GONE)
RESURVEY AT THE DIRECTION OF ALBERT E. CHAMPNEY, DIRECTOR OF WAYNE COUNTY BUREAU OF TAXATION
 W.P.A. (1930's), IRON, N-35, (#134)
 WITNESSES: E 89.50' 30" ASH (MEASURED 89.45')
 SE 83.65' 18" WALNUT (MEASURED 83.06 ± TO DEAD TREE)
 SW 103.87' OLD BRIDGE ABUTMENT (NW CORNER) (GONE)
 W 63.35' 29" ELM (GONE)
 12 DEC 96 2:16 P.M. RECEIPT# 62B
 RECORDED
 FEREST E. YOUNGBLOOD, REGISTER OF DEEDS
 WAYNE COUNTY, MI
 \$ 4.00 REMONUMENTATION

B. Description of corner evidence found and/or method applied in restoring or reestablishing corner.
 FOUND 3/8" REBAR IN CONC. MON. IN ROAD BOX (GOOD) IN THE CENTERLINE OF LILLEY ROAD (A TWO LANE ASPHALT APPROXIMATELY 650' NORTH OF THE MEDIAN OF MICHIGAN AVE.
 DISTANCE TO J-10 MEASURED AS 2645.94'; W.P.A. (1930's) RECORD DISTANCE OF 2647.01';
 DISTANCE TO I-11 TRAVERSED AS 2597.07'; G.L.O. (1819) RECORD DISTANCE OF 39.30 CHAINS (2593.80'); W.P.A. (1930's) RECORD DISTANCES OF 2597.77' AND 2597.71';
 DISTANCE TO K-11 TRAVERSED AS 2612.36'; G.L.O. (1819) RECORD DISTANCE OF 39.30 CHAINS (2593.80'); W.P.A. (1930's) RECORD DISTANCES OF 2612.35' AND 2611.95';
 W.C.R.C. SECTION CORNER WITNESS RECORD, IRON (1970)
 WITNESSES: NNE 84.50' WCRC TAG (NW SIDE) MICHIGAN BELL TELEPHONE POLE (GONE)
 E 89.42' WCRC TAG (S. SIDE) 35' ASH (MEASURED 89.45')
 SSE 40.09' WCRC TAG (SW SIDE) MICHIGAN BELL TELEPHONE POLE (GONE)
 WADE-TRIM/ASSOCIATES IN-HOUSE RECORDS, MON. IN ROAD BOX (1995), FB 1391 P. 67
 WITNESSES: N.27°38'E. 79.97' NAIL IN GLA #28400 TAG ON NW SIDE 8" TREE (MEASURED 79.95')
 S.32°38'E. 79.08' NAIL IN GLA #28400 TAG ON SW SIDE 2-8" TREE (MEASURED 79.10')
 S.28°00'W. 81.67' NAIL ON NW SIDE 8" TREE (MEASURED 81.69')
 N.48°37'W. 57.37' NAIL ON NE SIDE 24" TREE (MEASURED 57.46')

C. Description of monument for corner and accessories established to perpetuate locating the position of the corner.
 J-11, SECTION CORNER 26, 35 T.2S, R.8E.
 PLACED A REMONUMENTATION BRASS DISC AND PVC CAP #21586 ON 3/8" REBAR IN CONC. MON. IN ROAD BOX (GOOD) IN THE CENTERLINE OF LILLEY ROAD (A TWO LANE ASPHALT ROAD) APPROXIMATELY 650' NORTH OF THE MEDIAN OF MICHIGAN AVENUE AND IT IS ACCEPTED AS A CAREFUL AND FAITHFUL PERPETUATION OF THE POSITION OF THE ORIGINAL CORNER.
 WITNESSES: S.84°58'E. 89.45' FOUND NAIL IN WCRC BRASS REFERENCE DISC ON S. SIDE 48" ASH (SUPRA)
 S.74°38'W. 70.89' FOUND NAIL IN GLA PVC DISC ON N. SIDE 15" ELM
 S.82°53'W. 58.56' SET NAIL IN W.C.R. BRASS WITNESS DISC ON S. SIDE 15" ELM
 N.48°37'W. 57.46' FOUND PK NAIL IN WCRC BRASS REFERENCE DISC ON NE SIDE 24" ASH (SUPRA)

Signed by Walter J. Zbikowski
 WALTER J. ZBIKOWSKI
 Surveyor's Michigan License No. 21586

Date Dec. 11, 1996

Handwritten initials