

For corners in  
**SECTION**

WAYNE  
 (County)

Located in: Corner Code #  
 TOWNSHIP OF CANTON (#07)


- |                                       |     |      |     |
|---------------------------------------|-----|------|-----|
| 1. Public Land Survey                 | T2S | R 8E | K-3 |
|                                       | T   | R    |     |
|                                       | T   | R    |     |
|                                       | T   | R    |     |
| 2. Property Controlling in Section    | S   | T    | R   |
|                                       | S   | T    | R   |
| 3. Miscellaneous Property in Sec.     | S   | T    | R   |
|                                       | S   | T    | R   |
| 4. Lot No. _____, Recorded Plat _____ |     |      |     |
| 5. Private Claims _____               |     |      |     |

Compliance with  
 ACT 345, P.A. 1990

APPROVED ON: 11-13-97  
 WAYNE COUNTY REMONUMENTATION  
 PEER GROUP COMMITTEE

Register of Deeds Stamp & File Number

A	B	C	D	E	F	G	H	I	J	K	L	M
2	6		5		4		3		2		1	
3												
4	7		8		9		10		11		12	
5												
6	18		17		16		15		14		13	
7												
8	19		20		21		22		23		24	
9												
10	30		29		28		27		26		25	
11												
12	31		32									
13												

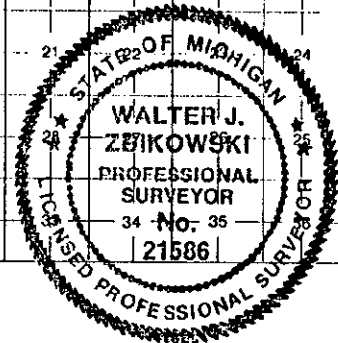

I, WALTER J. ZBIKOWSKI, in a field survey on NOVEMBER 25, 1997, do hereby certify that under requirements of P.A. 74, Michigan P.A. of 1970, the corner points mentioned in lines 1 and 2 above were in conformance with regulations and rules therefore as required in the current manual of survey instructions of the United States Department of the Interior, Bureau of Land Management or by a decree of a Court of Law and/or that the corner points mentioned in lines 3, 4 and 5 above were in conformance with the rules of the Michigan Board of Land Surveyors or by a Decree of a Court of Law, established, re-established, monumented, re-monumented, recovered, found as expressed below.

NOTE: Not more than 4 corners, all in the same town and range, may be recorded on this certificate.

A. Description of original monument and accessories and/or subsequent restoration.

**ORIGINAL GOVERNMENT SURVEY BY T. WAMPLER, D.S. (1815-1819)**  
 G.L.O. (1816) NORTH BETWEEN S 11 & 12, 80.00 CHAINS, SET POST COR. SEC. 1-2-11-12  
 WITNESSES: ELM 9" S 18 E 14 (LINKS) (9.24') (GONE)  
 ASPEN 6" N 52 W 19 (LINKS) (12.54') (GONE)

**RESURVEY AT THE DIRECTION OF ALBERT E. CHAMPNEY, DIRECTOR OF WAYNE COUNTY BUREAU OF TAXATION**  
 W.P.A. (1930's), CROSS ON STONE (#29) **\$10.00 DEED**  
 WITNESSES: N 18.25' (NAIL EAST SIDE) FENCE POST (GONE) **RECORDED**  
 S 20.60' (NAIL EAST SIDE) 18" WALNUT (GONE) **FOREST E. YOUNGBLOOD, REGISTER OF DEEDS**  
 W 2.00' (NAIL SOUTH SIDE) FENCE POST (GONE) **WAYNE COUNTY, MI**

B. Description of corner evidence found and/or method applied in restoring or reestablishing corner.  
 FOUND 1/2" REBAR (PVC CAP #18663/#19836) IN AN OPEN FIELD AND HUGGING THE SOUTH FACE OF A 2' HIGH X 18' SQUARE GABION AT THE EXTENSION OF THE CENTERLINES OF OLD HAGGERTY AND WARREN ROADS (BOTH UNIMPROVED)

DISTANCE TO K-2 TRAVERSED AS 2641.52' (AS ESTABLISHED OFF MONUMENTS IN "CAPITAL INDUSTRIAL PARK" (1987) L.101 P.97); TRAVERSED DISTANCE REVISED TO 2644.67' AS RESULT OF REMONUMENTATION PEER REVIEW OF CORNER K-2, G.L.O. (1816) RECORD DISTANCE OF 40.00 CHAINS (2640.00'); W.P.A. (1930's) RECORD DISTANCES OF 2644.71' AND 2644.77'; C.S. #765 (1978) L.18650 P.769-770 RECORD DISTANCE OF 2642.00'; PLAT (1987) L.101 P.97, "CAPITAL INDUSTRIAL PARK" RECORD DISTANCE OF 2639.89'; PLAT (1988) L.102 P.71, "KATY-MAR INDUSTRIAL SUB." RECORD DISTANCE OF 2645.32';

DISTANCE TO L-3 TRAVERSED AS 2749.88'; G.L.O. (1816) RECORD DISTANCE OF 41.01 CHAINS (2706.66'); W.P.A. (1930's) RECORD DISTANCES OF 2748.38' AND 2750.48';

DISTANCE TO K-4 TRAVERSED AS 2669.02'; G.L.O. (1816) RECORD DISTANCE OF 40.00 CHAINS (2640.00'); W.P.A. (1930's) RECORD DISTANCES OF 2668.90' AND 2669.25'; P.A. 132 CS (1978-NOT RECORDED) RECORD DISTANCE OF 2669.25';

(CONTINUED ON BACK)

**\$4.00 REMONUMENTATION**

C. Description of monument for corner and accessories established to perpetuate locating the position of the corner.

K-3, SECTION CORNER 1-2-11-12, T.2S., R.8E.  
 SET A 1/2" X 48" STEEL REBAR IN PLACE OF A 1/2" REBAR (CAP #18663/19836) IN AN OPEN FIELD AND HUGGING THE SOUTH FACE OF A 2' HIGH X 18' SQUARE GABION AT THE EXTENSIONS OF THE CENTERLINES OF OLD HAGGERTY AND WARREN ROADS (BOTH UNIMPROVED) AND IT IS SUBJECT TO APPROVAL OF THE WAYNE COUNTY REMONUMENTATION COMMISSION AS TO ITS PROPER LOCATION AND TYPE. (GRANTED 11/13/97 AND THE SET 1/2" X 48" REBAR IS ACCEPTED AS A CAREFUL AND FAITHFUL PERPETUATION OF THE POSITION OF THE ORIGINAL CORNER.)

WITNESSES: S 83°45' E 87.00' SET CHISELED "X" ON WEST RIM OF STORM MANHOLE  
 S 34°06' W 41.61' SET NAIL/WCR BRASS DISC ON SOUTHEAST SIDE OF 10" ASH (SUPRA)  
 S 85°02' W 26.31' SET NAIL/WCR BRASS DISC ON NORTH SIDE OF 12" COTTONWOOD  
 N 14°19' W 5.44' FOUND CHISELED "X" ON SOUTHEAST RIM OF MANHOLE (SUPRA)

PLACED A REMONUMENTATION BRASS DISC AND PVC CAP #21586 ON ABOVE 1/2" X 48" STEEL REBAR K-3.

Signed by Walter J. Zbikowski  
 WALTER J. ZBIKOWSKI

Date DEC. 8, 1997

Surveyor's Michigan License No. 21586

B. CONTINUED

DISTANCE TO J-3 TRAVERSED AS 2616.49'; G.L.O. (1816) RECORD DISTANCE OF 39.75 CHAINS (2623.50'); W.P.A. (1930's) RECORD DISTANCES OF 2617.32' AND 2617.61'; CS #765 (1973) L.18650 P.769-770 RECORD DISTANCE OF 2616.45'; CS #947 (1974) L. 18859 P. 648 RECORD DISTANCE OF 2616.45'; L.18650 P.768, FOUND 1/2" ROD (1973) LCRC #293

WITNESSES: N 15°38' W 5.34' CHISELED CROSS ON SOUTHEAST EDGE OF MH RIM (MEASURED 5.44')

N 36°31' W 1.27' NAIL EAST SIDE OF FENCE POST (GONE)  
 S 04°00' W 20.59' 30" WALNUT TREE, MSHD NAIL IN EAST SIDE (GONE)

NOTE: SAME WITNESSES AND CORNER IDENTIFICATION APPEAR IN L.18650 P.769-770, C.S. #765 (1973) AND L.18859 P.648 CS #947 (1974)

L.20296 P. 563, SET 1/2" IRON (1978) LCRC #627

WITNESSES: NW'LY 2.90' NAIL IN FENCE POST (GONE)  
 NW'LY 1.30' FOUND IRON STAKE (GONE)  
 W 1.50' FENCE LINE (GONE)  
 SW'LY 18.85' PK NAIL IN 24" TREE (GONE)

RE-ESTABLISHED BY EXTENDING SECTION LINE FROM WEST 1/4 CORNER (K-4) THROUGH FOUND IRON IN CENTERLINE OF WARREN (THE RECORDED DISTANCE FROM CENTERLINE OF WARREN TO NORTHWEST CORNER OF SECTION 12 (K-3) IS 715.33') (MEASURED 715.36' BUT FOUND THE EXISTING 1/2" REBAR TO BE 1.08' W OF SAID CENTERLINE PROLONGATION.)

WADE-TRIM/ASSOCIATES, INC. IN-HOUSE RECORDS (1993) REMONUMENTATION LCRC FORM.

WITNESSES: N. 13°04' W 5.36' CROSS IN SOUTHEAST RIM OF MN (MEASURED 5.44')  
 DUE NORTH 41.06' 5/8" IRON PIPE (MEASURED 41.11')  
 S. 34°53' W 42.58' NAIL AND TAG (GONE) SOUTH SIDE 8" TREE (MEASURED 42.61'±)  
 S. 82°57' W 26.32' NAIL AND TAG (RECESSED) SOUTH SIDE 8" TREE (MEASURED 26.21')

FILE DO NOT MAIL

SURVEY &  
 REMONUMENTATION

MAR 17 1998

SECTION