

MAR 17 1998

FILE DO NOT MAIL

LAND CORNER RECORDATION CERTIFICATE
Filing Requirement of Act 74, Mich. P.A. 1970

Liber-29739 Page-557.0
97327842LS 12/15/1997 08:46AM

For corners in

| | | |
|---------------------------------------|---|----------------------|
| <u>WAYNE</u> (County) | Located in: TOWNSHIP OF CANTON (#07) | Corner Code # K-4 |
| 1. Public Land Survey | T2S R 8E | |
| | T R | |
| | T R | |
| | T R | |
| 2. Property Controlling in Section | S T R | |
| | S T R | |
| 3. Miscellaneous Property in Sec. | S T R | |
| | S T R | |
| 4. Lot No. _____, Recorded Plat _____ | | |
| 5. Private Claims _____ | | |


Compliance with
ACT 345, P.A. 1990
APPROVED ON: 11-13-97
WAYNE COUNTY REMONUMENTATION
PEER GROUP COMMITTEE

Register of Deeds Stamp & File Number

I, WALTER J. ZBIKOWSKI, in a field survey on NOVEMBER 25, 1997, do hereby certify that under requirements of P.A. 74, Michigan P.A. of 1970, the corner points mentioned in lines 1 and 2 above were in conformance with regulations and rules therefore as required in the current manual of survey instructions of the United States Department of the Interior, Bureau of Land Management or by a decree of a Court of Law and/or that the corner points mentioned in lines 3, 4 and 5 above were in conformance with the rules of the Michigan Board of Land Surveyors or by a Decree of a Court of Law; established, re-established, monumented, re-monumented, recovered, found as expressed below.

NOTE: Not more than 4 corners, all in the same town and range, may be recorded on this certificate.

| A | B | C | D | E | F | G | H | I | J | K | L | M |
|----|----|---|----|---|----|---|----|---|----|---|----|---|
| 2 | 6 | | 5 | | 4 | | 3 | | 2 | | 1 | |
| 3 | | | | | | | | | | | | |
| 4 | 7 | | 8 | | 9 | | 10 | | 11 | | 12 | |
| 5 | | | | | | | | | | | | |
| 6 | 18 | | 17 | | 16 | | 15 | | 14 | | 13 | |
| 7 | | | | | | | | | | | | |
| 8 | 19 | | 20 | | 21 | | 22 | | 23 | | 24 | |
| 9 | | | | | | | | | | | | |
| 10 | 30 | | 29 | | 28 | | 27 | | 26 | | 25 | |
| 11 | | | | | | | | | | | | |
| 12 | 31 | | 32 | | 33 | | 34 | | 35 | | 36 | |
| 13 | | | | | | | | | | | | |

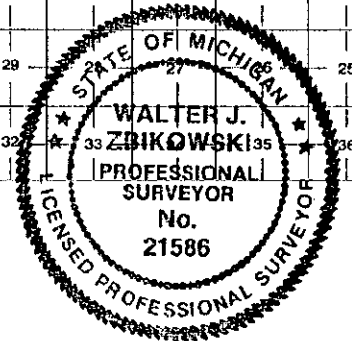

A. Description of original monument and accessories and/or subsequent restoration.

ORIGINAL GOVERNMENT SURVEY BY T. WAMPLER, D.S. (1815-1819)
G.L.O. (1816) NORTH BETWEEN SEC. 11 & 12, 40.00 (CHAINS), SET 1/2 MI POST
WITNESSES: ASH 14" N 26 E 13 (LINKS) (8.58') (GONE)
DO 8" S 86 W 16 (LINKS) (10.56') (GONE)

RESURVEY AT THE DIRECTION OF ALBERT E. CHAMPNEY, DIRECTORY OF WAYNE COUNTY BUREAU OF TAXATION
W.P.A. (1930's) CROSS ON STONE, W-12 (#50)
WITNESSES: ENE 32.08' 4" ELM (GONE)
SSW 44.07' 40" MAPLE (GONE)
SW 67.95' 14" APPLE (GONE)
NNW 38.80' 20" ELM (GONE)

\$4.00 REMONUMENTATION
RECORDED
FOREST E. YOUNGBLOOD, REGISTER OF DEEDS
WAYNE COUNTY, MI
Receipt #41828

B. Description of corner evidence found and/or method applied in restoring or reestablishing corner.
FOUND A 1" REBAR (2" DEEP) JUST OFF CENTER TO THE WEST IN OLD HAGGERTY ROAD (A 22' WIDE GRAVEL ROAD) AT 1953'± SOUTH OF WARREN ROAD.
DISTANCE TO K-3 TRAVERSED AS 2669.02'; G.L.O. (1816) RECORD DISTANCE OF 40.00 CHAINS (2640.00'); W.P.A. (1930's) RECORD DISTANCES OF 2668.90' AND 2669.25'; "FOX CREEK SUBDIVISION" (L. 25921 P. 321) (1992) RECORD DISTANCE OF 2668.97';
DISTANCE TO K-5 TRAVERSED AS 2649.90'; G.L.O. (1816) RECORD DISTANCE OF 40.00 CHAINS (2640.00'); W.P.A. (1930's) RECORD DISTANCES OF 2649.47' AND 2649.97';
W.C.R.C. (1970) 1-1/2" PIPE, 4" LONG OVER STONE, W 1/4 COR. SECT 12, (#50)
WITNESSES: ENE 26.70' W.C.R.C. TAG (REPLACED WITH 60D NAIL/BRASS DISK) (NW/S) 8" ASH (MEASURED 26.57')
SE 47.50' W.C.R.C. TAG (SW/S) 12" BOX ELDER (DECAYED STUMP) (MEASURED 47.44')
SW 45.70' MSHD TAG (NW/S) (NO DESCRIPTION OF WITNESS IN NOTES) (GONE)
W 33.23' PROPERTY IRON (MEASURED 33.18')
NW 55.00' MSHD TAG (GONE) (NE/S) 30" OAK (TREE HAS MULTIPLE NAILS)

(CONTINUED ON BACK)

\$10.00 DEED

C. Description of monument for corner and accessories established to perpetuate locating the position of the corner.
K-4, SECTION CORNER 11-12, T.2S., R.8E
SET A 1/2" X 36" STEEL REBAR (TOP ± 6" BELOW GRAVEL SURFACE) JUST OFF CENTER TO THE WEST IN OLD HAGGERTY ROAD (A 22' WD GRAVEL ROAD) AT 1953'± SOUTH OF WARREN ROAD AND IT IS ACCEPTED AS A CAREFUL AND FAITHFUL PERPETUATION OF THE POSITION OF THE ORIGINAL CORNER.
WITNESSES: N 67°41' S 26.57' FOUND 60D NAIL/BRASS DISK ON NORTHWEST SIDE OF 12" ASH (SUPRA)
S 39°08' W 34.76' FOUND 60D NAIL/BRASS DISK ON EAST SIDE OF TWIN ELM
S 89°49' W 38.97' FOUND 60D NAIL/BRASS DISK ON NORTH SIDE OF 36" OAK
N 30°15' W 54.34' FOUND 60D NAIL/BRASS DISK ON NORTHEAST SIDE OF 48" OAK
PLACED A REMONUMENTATION ALUMINUM DISC STAMPED WITH LLS #21586 ON ABOVE 1/2" X 36" STEEL REBAR K-4.

Signed by Walter J. Zbikowski Date DEC. 8, 1997
WALTER J. ZBIKOWSKI
Surveyor's Michigan License No. 21586

DP-1

B. CONTINUED

L. 18128 P. 382, FOUND 1/2" I.P. FROM OLD REFERENCES (1972) LCRC #98
 WITNESSES: E 26.94' NAIL AND CAP (NOW 60D NAIL/BRASS DISK) N SIDE 8" ASH (MEASURED 26.57')
 SE 47.61' NAIL AND CAP SW SIDE 10" B.E. (BOX ELDER) (DECAYED STUMP) (MEASURED 47.44')
 SW 45.52' NAIL AND CAP NW SIDE 40" MAPLE (GONE)
 NW 54.84' NAIL AND CAP (GONE) NE SIDE 28" OAK (TREE HAS MULTIPLE NAILS)

L. 20296 P. 563, FOUND 1-1/2" SOLID IRON, W 1/4 CORNER SEC 12 (1978) LCRC #627
 WITNESSES: N'LY 26.50' PK NAIL (NOW 60D NAIL/BRASS DISK) IN 12" TREE (MEASURED 26.57')
 SW'LY 45.64' PK NAIL IN 42" TREE (GONE)
 WEST 33.31' FOUND IRON STAKE (MEASURED 33.18')
 NW'LY 54.94' PK NAIL (NE/S) IN 24" TREE (MEASURED 54.19')

L. 21876 P. 869, 1" IRON PIPE, K-4 (1983) #825
 WITNESSES: SE 47.54' NAIL/WCRC TAG IN WEST SIDE 12" BOX ELDER (DECAYED STUMP)(MEASURED 47.44')
 SW 38.88' NAIL/WCRC TAG (GONE) IN EAST SIDE TWIN TREE
 NW 54.12' NAIL/WCRC TAG (NOW PK NAIL) IN NE SIDE 30" OAK (MEASURED 54.19')

WCPS (1987), 3/4" BAR, E. 1/4 COR 11, (#50)
 WITNESSES: NE 34.68' SET HORZ NAIL WCRC TAG (GONE) ON NW SIDE 5" OAK (MEASURED 34.8±)
 E 22.91' FOUND HORZ NAIL WCRC TAG ON N SIDE 15" OAK (MEASURED 22.96')
 SW 35.22' FOUND NAIL WITH WCRC TAG (GONE, NOW A HOLE ONLY) SE SIDE 10" OAK (TWIN ELM) (MEASURED 35.04')
 W 38.90' FOUND HORZ NAIL WCRC TAG N SIDE 22" OAK (MEASURED 38.84')
 NW 54.45' SET HORZ NAIL WCRC TAG (GONE) SW SIDE 34" WALNUT

SURVEY & REMONUMENTATION

MAR 17 1998

SECTION

FILE DO NOT MAIL