

APR 05 1996

LAND CORNER RECORDATION CERTIFICATE
Filing Requirement of Act 74, Mich. P.A. 1970

\$ 4.00 REMONUMENTATION

\$ 10.00 DEED

7 DEC 95 11:07 A.M. RECEIP

RECORDED

FOREST E. YOUNGBLOOD, REGISTER
WAYNE COUNTY, MI

LIBER 28448 PAGE 900

Compliance with
ACT 345, P.A. 1990

APPROVED ON: 12-4-95
WAYNE COUNTY REMONUMENTATION
PEER GROUP COMMITTEE

Register of Deeds Stamp & File Number


For corners in COMMISSION

WAYNE Located in: Corner Code #
(County) TOWNSHIP OF CANTON #07

- 1. Public Land Survey T2S R8E K-6
T R
T R
T R
- 2. Property Controlling S T R
In Section S T R
- 3. Miscellaneous S T R
Property in Sec. S T R
- 4. Lot No. Recorded Plat
- 5. Private Claims

I, WALTER J. ZBIKOWSKI, in a field survey on SEPTEMBER 19, 1995, do hereby certify that under requirements of P.A. 75, Michigan P.A. of 1970, the corner points mentioned in lines 1 and 2 above were in conformance with regulations and rules therefore as required in the current manual of survey instructions of the United States Department of the Interior, Bureau of Land Management or by a decree of a Court of Law and/or that the corner points mentioned in lines 3, 4 and 5 above were in conformance with the rules of the Michigan Board of Land Surveyors or by a Decree of a Court of Law; established, re-established, monumented, re-monumented, recovered, found as expressed below.

NOTE: Not more than 4 corners, all in the same town and range, may be recorded on this certificate.

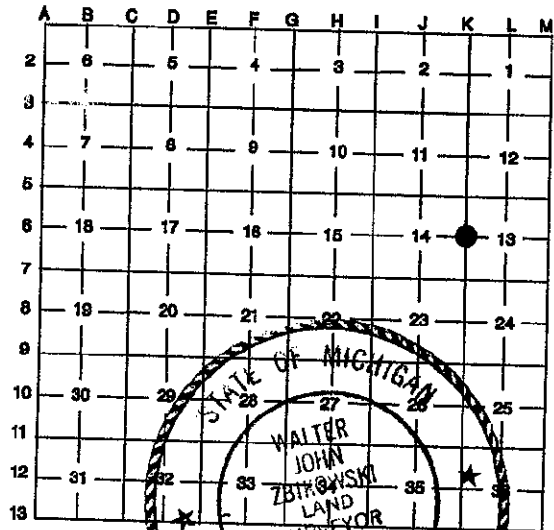

95261588

A. Description of original monument and accessories and/or subsequent restoration.
ORIGINAL GOVERNMENT SURVEY BY T. WAMPLER, D.S. (1815-1819)
G.L.O. (1819) SET 1/2 MI POST (DESCRIPTION OF CORNER NOT STATED IN NOTES)
WITNESSES: ASH 8 N 58-1/2 W 21 (13.86' REC) (GONE)
DO 6 N 64 E 20 (13.20' REC) (GONE)
RESURVEY AT THE DIRECTION OF ALBERT E. CHAMPNEY, DIRECTOR OF WAYNE COUNTY BUREAU OF TAXATION
(CONTINUED ON BACK)

B. Description of corner evidence found and/or method applied in restoring or reestablishing corner.
FOUND A 1" IRON PIPE SET IN CONCRETE IN A ROAD BOX (GOOD) IN CENTER OF NORTH BOUND HAGGERTY ROAD (A TWO LANE CONCRETE ROAD).
DISTANCE TO K-7 MEASURED AS 2659.87'; RECORD G.L.O. (1819) DISTANCE OF 40.00 CHAINS (2640.00') RECORD W.P.A. (1930s) DISTANCES OF 2659.51' AND 2658.69'
DISTANCE TO K-5 MEASURED AS 2640.66'; RECORD G.L.O. (1819) DISTANCE OF 40.00 CHAINS (2640.00') RECORD W.P.A. (1930s) DISTANCES OF 2640.65' AND 2640.64'
L.18160 P.261-262 FOUND MONUMENT STEEL CLAD (1972) LCRC #127
NNE 169.28' (PK NAIL IN) G.W. TAG #1832 (GONE) IN W. FACE OF UTILITY POLE (MEASURED 169.04')
E 58.84' (PK NAIL IN) G.W. TAG #1834 (GONE) IN S. FACE OF UTILITY POLE (MEASURED 58.76')
SSW 99.22' (PK NAIL IN) G.W. TAG #1833 IN E. FACE OF UTILITY POLE (MEASURED 99.51')
NW 76.46' (PK NAIL IN) G.W. TAG #1835 (GONE) IN NE FACE OF 24" TREE (MEASURED 76.50')
(CONTINUED ON BACK)

C. Description of monument for corner and accessories established to perpetuate locating the position of the corner.
K-6 SECTION CORNER 13, 14 T.2S., R.8E
A 1" IRON PIPE SET IN CONCRETE IN A ROAD BOX WITH WCRC BM LID (GOOD) IN CENTER OF NORTH BOUND HAGGERTY ROAD (A TWO LANE CONCRETE ROAD) AND IT IS ACCEPTED AS A CAREFUL AND FAITHFUL PERPETUATION OF THE POSITION OF THE ORIGINAL CORNER.
WITNESSES: N.84°50'E. 59.06' NAIL IN WCRC BRASS REFERENCE DISC ON S. SIDE OF UTILITY POLE (SUPRA)
S.57°14'E. 70.14' EXTREME SW CORNER TO CONCRETE BASE OF AMERITECH CONTROL PEDESTAL
S.17°36'W. 99.61' NAIL IN WCRC BRASS REFERENCE DISC ON E. SIDE OF UTILITY POLE (SUPRA)
N.55°24'W. 76.50' SET WCR BRASS WITNESS DISC ON NE SIDE OF 24" TREE (SUPRA)

PLACED A REMONUMENTATION BRASS DISC AND PVC CAP #21586 ON ABOVE FOUND 1" IRON PIPE K-6

Signed by Walter J. Zbikowski Date Dec. 6, 1995
WALTER J. ZBIKOWSKI
Surveyor's Michigan License No. 21586

4
10 w

SECTION A (CONTINUED)

W.P.A. (1930s) MON W-13 (#76)

WITNESSES: ENE 43.00'
ESE 30.67'
W 63.25'

W.C.R.C. (1970) MON. W-13 (#76)

WITNESSES: NE 59.59'
E 59.06'
WNW 76.52'
NNW 115.55'

POLE (GONE)
16" TWIN ELM (GONE)
6" ELM (GONE)

LIBER 28448 PAGE 901

"X" CUT W/RIM SAN. MH (MEASURED 59.42')
DETROIT EDISON POLE (GONE)
(NAIL N. SIDE - GONE) 18" ELDER (MEASURED 76.50')
(NAIL NE SIDE - GONE) MICHIGAN BELL TELEPHONE POLE (MEASURED 115.30')

SECTION B (CONTINUED)

L.18160 P.263 FOUND MONUMENT (1972) CS #232

SAME WITNESSES AS L.18160 P.261-262 ABOVE.

L.18603 0.257 1" IRON ENCASED IN CONCRETE MONUMENT (1973) LCRC #275

N.85°E. 59.23' NAIL IN WCRC BRASS REFERENCE DISC IN S. SIDE OF UTILITY POLE (MEASURED 59.06')

S.28°W. 99.20' NAIL IN WCRC BRASS REFERENCE DISC IN E. FACE OF UTILITY POLE (MEASURED 99.61')

N.60°W. 76.52' NAIL IN WCRC BRASS REFERENCE DISC (GONE) IN NE FACE OF 24" TREE (MEASURED 76.50')

L.18694 P.643-644 WEST 1/4 COR. OF SEC. 13 (1973) CS #232 (DESCRIPTION OF CORNER NOT STATED IN NOTES)

SAME WITNESSES AS L.18160 P.261-262 ABOVE.