

FEB 28 1994

LAND CORNER RECORDATION CERTIFICATE
Filing Requirement of Act 74, Mich. P.A. 1970

For corners in
WAYNE COMMISSION
(County)

Located In:
TWP. OF CANTON

Corner Code: #

1. Public Land Survey	T	2S	R	8E	K-7
	T		R		
	T		R		
	T		R		
2. Property Controlling in Section	S		T	R	
	S		T	R	
3. Miscellaneous Property in Sec.	S		T	R	
	S		T	R	

Compliance with
ACT 345, P.A. 1990
APPROVED ON: 12-10-93 [Signature]
WAYNE COUNTY REMONUMENTATION
PEER GROUP COMMITTEE

RC 1287

Register of Deeds Stamp & File Number

- 4. Lot No. _____, Recorded Plat _____
- 5. Private Claims _____

A	B	C	D	E	F	G	H	I	J	K	L	M
2	6	5	4	3	2	1						
3												
4	7	8	9	10	11	12						
5												
6	18	17	16	15	14	13						
7												
8	19	20	21	22	23	24						
9												
10	30	29	28	27	26	25						
11												
12	31	32	33	34	35	36						
13												

I, E. PATRICK O'ROURKE, in a field survey on DECEMBER 7, 1993, do hereby certify that under requirements of P.A. 74, Michigan P.A. of 1970, the corner points mentioned in lines 1 and 2 above were in conformance with regulations and rules therefore as required in the current manual of survey instructions of the United States Department of the Interior, Bureau of Land Management or by a decree of a Court of Law and/or that the corner points mentioned in lines 3, 4 and 5 above were in conformance with the rules of the Michigan Board of Land Surveyors or by a Decree of a Court of Law; established, re-established, monumented, re-monumented, recovered, found as expressed below:

NOTE: Not more than 4 corners, all in the same town and range, may be recorded on this certificate.

A. Description of original monument and accessories and/or subsequent restoration:

G.L.O. (1815-1816) DESCRIPTION OF MONUMENT NOT STATED IN NOTES

WITNESSES: ELM 5 S67W 6 (3.96') (GONE)
DO 7 N44E 20 (13.20') (GONE)

WPA (1930's) IRON SET OVER STONE (#81)

WITNESSES: NE 52.15' SW CORNER CULVERT HEADWALL (GONE) SW 41.55' NAIL NORTHWEST SIDE TEL. POLE (GONE)
SE 37.65' NAIL IN NE SIDE TEL. POLE (GONE) NW 54.10' SE CORNER CULVERT HEADWALL (GONE)
S 68.25' NAIL WEST SIDE 14" PEAR (GONE)


B. Description of corner evidence found and/or method applied in restoring or reestablishing corner:

DISTANCE TO J-7 MEASURED AS 2618.54'; RECORDED WPA (1930) DISTANCES AS 2618.45' AND 2618.26';
DISTANCE TO K-6 MEASURED AS 2659.88'; RECORDED WPA (1930) DISTANCES AS 2659.51' AND 2658.69';
DISTANCE TO K-8 MEASURED AS 2675.09'; RECORDED WPA (1930) DISTANCES AS 2674.64' AND 2775.0'

L.18398 P.540 FOUND IRON ROD IN MON. BOX (CS) (1973)
NO TIES ON CS

L.18398 P.541 FOUND IRON ROD IN MON. BOX (CS) (1973)
NO TIES ON CS

L.18603 P.253 1/2" IRON IN MON. BOX (1973)
N 40°W 55.33' CHISELED "X" 1" NORTH OF SOUTH END OF HEADWALL (GONE)
N 35°E 53.49' CHISELED "X" 1" NORTH OF SOUTH END OF HEADWALL (GONE)
S 45°W 54.11' NAIL WITH FLASHER (WAYNE COUNTY ROAD COMMISSION) NORTHWEST FACE OF UTILITY POLE (GONE)

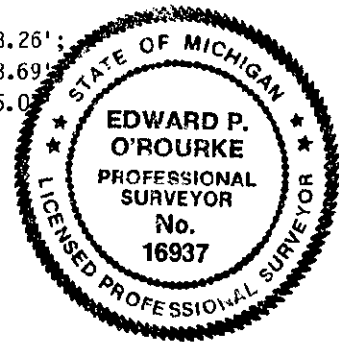

C. Description of monument for corner and accessories established to perpetuate locating the position of the corner:

SECTION CORNER 13, 14, 23, 24 T2S R8E

FOUND 1/2" IRON PIPE IN CONCRETE IN MONUMENT BOX AND IT IS ACCEPTED AS A CAREFUL AND FAITHFUL PERPETUATION OF THE POSITION OF THE ORIGINAL CORNER.

WITNESSES: N 35°50'E 97.44' NAIL IN TAG (GLA #28400) WEST SIDE OF UTILITY POLE (FOUND)
N 46°23'W 74.34' NAIL IN TAG (GLA #28400) SOUTHWEST SIDE OF UTILITY POLE (FOUND)
N 48°22'W 71.75' NAIL IN TAG (GLA #28400) SOUTHEAST SIDE OF UTILITY POLE (FOUND)
S 41°50'E 64.22' NAIL IN TAG (GLA #28400) SOUTHWEST SIDE OF UTILITY POLE (FOUND)

PLACED A REMONUMENTATION BRASS DISC AND CAP #16937 ON ABOVE 1/2" IRON K-7

Signed by [Signature]
E. PATRICK O'ROURKE
Surveyor's Michigan License No. 16937

Date DECEMBER 7, 1993

[Handwritten initials]

RECORDED
INDEXED
FEB 28 1994