

LAND CORNER RECORDATION CERTIFICATE  
Filing Requirement of Act 74, Mich. P.A. 1970

APR 05 1996

\$ 4.00 REMONUMENTATION  
\$ 10.00 DEED  
7 DEC 95 11:07 A.M. RECEIPT

For corners in COMMISSION

<u>WAYNE</u> (County)	Located in: TOWNSHIP OF CANTON #07	Corner Code # K-9
1. Public Land Survey	T2S R8E	
	T R	
	T R	
	T R	
2. Property Controlling in Section	S T R	
	S T R	
3. Miscellaneous Property in Sec.	S T R	
	S T R	
4. Lot No. _____, Recorded Plat _____		
5. Private Claims _____		

RECORDED  
FOREST E. YOUNGBLOOD, REGISTER  
WAYNE COUNTY, MI  
Compliance with  
ACT 345, P.A. 1990  
APPROVED ON: 12-4-95  
WAYNE COUNTY REMONUMENTATION  
PEER GROUP COMMITTEE  
Register of Deeds Stamp & File Number

I, WALTER J. ZBIKOWSKI, in a field survey on SEPTEMBER 25, 1995, do hereby certify that under requirements of P.A. 75, Michigan P.A. of 1970, the corner points mentioned in lines 1 and 2 above were in conformance with regulations and rules therefore as required in the current manual of survey instructions of the United States Department of the Interior, Bureau of Land Management or by a decree of a Court of Law and/or that the corner points mentioned in lines 3, 4 and 5 above were in conformance with the rules of the Michigan Board of Land Surveyors or by a Decree of a Court of Law; established, re-established, monumented, re-monumented, recovered, found as expressed below.

A	B	C	D	E	F	G	H	I	J	K	L	M
2	6		5		4		3		2		1	
3												
4	7		8		9		10		11		12	
5												
6	18		17		16		15		14		13	
7												
8	19		20		21		22		23		24	
9												
10	30		29		28		27		26		25	
11												
12	31		32		33		34		35		36	

NOTE: Not more than 4 corners, all in the same town and range, may be recorded on this certificate.

A. Description of original monument and accessories and/or subsequent restoration.

ORIGINAL GOVERNMENT SURVEY BY T. WAMPLER, D.S. (1815-1819)  
G.L.O. (1819) SET POST COR S 23, 24, 25 & 26 (DESCRIPTION OF CORNER NOT STATED IN NOTES)  
WITNESSES: BEECH 12 N 62 E 5-1/2 (3.63 REC) (GONE)  
DO 15 S 52-1/2 W 26 (17.16 REC) (GONE)


RESURVEY AT THE DIRECTION OF ALBERT E. CHAMPNEY, DIRECTOR OF WAYNE COUNTY BUREAU OF TAXATION

(CONTINUED ON BACK)

B. Description of corner evidence found and/or method applied in restoring or reestablishing corner.

FOUND A 1/2" REBAR IN CONCRETE MONUMENT IN A ROAD BOX (GOOD) AT THE INTERSECTION OF HAGGERTY AND PALMER ROADS (BOTH CONCRETE ROADS AT INTERSECTION).  
DISTANCE TO K-10 MEASURED AS 2641.82'; RECORD G.L.O. (1819) DISTANCE OF 40.00 CHAINS (2640.00') RECORD W.P.A. (1930s)  
DISTANCES OF 2641.53' AND 2640.81'  
DISTANCE TO L-9 TRAVERSED AS 2707.84'; RECORD G.L.O. (1819) DISTANCE OF 41.04 CHAINS (2708.64') RECORD W.P.A. (1930s)  
DISTANCES OF 2706.38' AND 2705.54'  
DISTANCE TO K-8 MEASURED AS 2675.11'; RECORD G.L.O. (1819) DISTANCE OF 40.00 CHAINS (2640.00') RECORD W.P.A. (1930s)  
DISTANCES OF 2675.03' AND 2674.59'

(CONTINUED ON BACK)

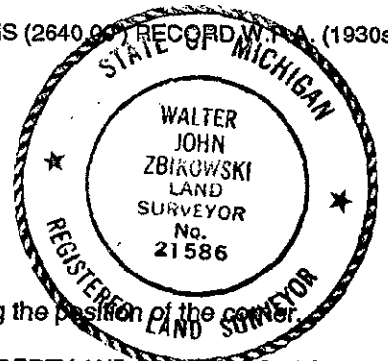

C. Description of monument for corner and accessories established to perpetuate locating the position of the corner.

K-9 SECTION CORNER 23, 24, 25, 26 T.2S., R.8E  
A 1/2" REBAR IN CONCRETE MONUMENT IN ROAD BOX (GOOD) AT THE INTERSECTION OF HAGGERTY AND PALMER ROADS (BOTH CONCRETE ROADS AT THE INTERSECTION) AND IT IS ACCEPTED AS A CAREFUL AND FAITHFUL PERPETUATION OF THE POSITION OF THE ORIGINAL CORNER.  
WITNESSES: N.32°49'E. 117.79' NAIL IN WCRC BRASS REFERENCE DISC ON NW SIDE OF UTILITY POLE (SUPRA)  
S.54°07'E. 79.58' NAIL IN WCRC BRASS REFERENCE DISC ON SW SIDE OF UTILITY POLE (SUPRA)  
S.47°32'W. 55.97' NAIL IN WCRC BRASS REFERENCE DISC ON NW SIDE OF UTILITY POLE (SUPRA)  
N.42°07'W. 72.53' NAIL IN WCRC BRASS REFERENCE DISC ON NE SIDE OF UTILITY POLE (SUPRA)

PLACED A REMONUMENTATION BRASS DISC AND PVC,CAP #21586 ON ABOVE FOUND CONCRETE MONUMENT K-9.

Signed by Walter J. Zbikowski  
WALTER J. ZBIKOWSKI  
Surveyor's Michigan License No. 221586

Date DEC. 6, 1995

4  
10 L

SECTION A (CONTINUED)

W.P.A. (1930s) STAKE OVER STONE IN TILE NW 25 (#107)  
 WITNESSES: NE 74.28 TELEPHONE POLE (GONE)  
 SE 57.17 TELEPHONE POLE (GONE)  
 SW 35.36 14" ELM (GONE)  
 NW 39.32 TELEPHONE POLE (GONE)

LIBER 28448 PAGE 905

W.C.R.C. (1970) IRON NW 25 (#107)  
 WITNESSES: NE 36.80 WCRC SIGN POST (GONE)  
 SE 66.20 DETROIT EDISON POLE (GONE)  
 SW 56.00 (PK NAIL IN WCRC BRASS REFERENCE DISC NW SIDE) GUY POLE (MEASURED 55.97)  
 NW 38.62 MICHIGAN BELL TELEPHONE POLE (GONE)

SECTION B (CONTINUED)

L.18206 P.521 FOUND 1" DIAMETER IRON (1972) LCRC #134  
 N.42°W. 38.35' PK NAIL IN TELEPHONE POLE (GONE)  
 S.48°W. 55.95' PK NAIL (IN WCRC BRASS REFERENCE DISK ON NW SIDE) POWER POLE (MEASURED 55.97)  
 S.56°E. 66.30' PK NAIL IN POWER POLE (GONE)  
 L.20402 P.904 FOUND 1/2" IRON PIPE (1978) LCRC #640  
 N.40°E. 61.86' EXTREME S EDGE GV&W (MEASURED 61.76)  
 S.56°E. 66.11' REF. NAIL SW SIDE POLE (GONE)  
 S.48°W. 55.90' NAIL (IN WCRC BRASS REFERENCE DISC IN) SE (NW) SIDE GUY POLE (MEASURED 55.97)  
 N.45°W. 38.30' REF. NAIL E. SIDE POLE (GONE)  
 L.20887 P.665 FOUND 1" IRON PIPE (1980) LCRC #728  
 N.32°E. 117.33' PK NAIL W SIDE DETROIT EDISON POLE (MEASURED 117.36)  
 S.57°E. 66.23' PK NAIL NE SIDE DETROIT EDISON POLE (GONE)  
 S.47°W. 55.91' PK NAIL (IN WCRC BRASS REFERENCE DISC IN) NW SIDE GUY POLE (MEASURED 55.97)  
 N.44°W. 38.38' PK NAIL SW SIDE MICHIGAN BELL TELEPHONE POLE (GONE)  
 L.26633 P.147 FOUND CONCRETE MONUMENT IN MONUMENT BOX (1992) LCRC #1070  
 N.35°E. 117.79' NAIL IN WCRC BRASS REFERENCE DISC NW FACE OF UTILITY POLE (MEASURED 117.79)  
 S.50°E. 79.58' NAIL IN WCRC BRASS REFERENCE DISC SW FACE OF UTILITY POLE (MEASURED 79.58)  
 S.45°W. 55.88' NAIL IN WCRC BRASS REFERENCE DISC NW FACE OF UTILITY POLE (MEASURED 55.97)  
 N.40°W. 72.54' NAIL IN WCRC BRASS REFERENCE DISC IN NE FACE OF UTILITY POLE (MEASURED 72.53)