

APR 05 1996

**LAND CORNER RECORDATION CERTIFICATE**  
 Filing Requirement of Act 74, Mich. P.A. 1970

\$ 4.00 REMONUMENTATION  
 \$ 10.00 DEED  
 7 DEC 95 11:07 A.M. RECEIP  
 RECORDED  
 FOREST E. YOUNGBLOOD, REGISTER  
 WAYNE COUNTY, MI

For corners in **COMMISSION**

<u>WAYNE</u> (County)	Located in: TOWNSHIP OF CANTON #07	Corner Code # K-10
1. Public Land Survey	T2S R8E	
	T _____ R _____	
	T _____ R _____	
	T _____ R _____	
2. Property Controlling in Section	S _____ T _____ R _____	
	S _____ T _____ R _____	
3. Miscellaneous Property in Sec:	S _____ T _____ R _____	
	S _____ T _____ R _____	
4. Lot No. _____, Recorded Plat _____		
5. Private Claims _____		


Compliance with  
 ACT 345, P.A. 1990  
 APPROVED ON: 12-4-95  
 WAYNE COUNTY REMONUMENTATION  
 PEER GROUP COMMITTEE  
 Register of Deeds Stamp & File Number

I, WALTER J. ZBIKOWSKI, in a field survey on SEPTEMBER 5, 1995, do hereby certify that under requirements of P.A. 75, Michigan P.A. of 1970, the corner points mentioned in lines 1 and 2 above were in conformance with regulations and rules therefore as required in the current manual of survey instructions of the United States Department of the Interior, Bureau of Land Management or by a decree of a Court of Law and/or that the corner points mentioned in lines 3, 4 and 5 above were in conformance with the rules of the Michigan Board of Land Surveyors or by a Decree of a Court of Law; established, re-established, monumented, re-monumented, recovered, found as expressed below.

**NOTE:** Not more than 4 corners, all in the same town and range, may be recorded on this certificate.

A	B	C	D	E	F	G	H	I	J	K	L	M
2	6		5		4		3		2		1	
3												
4	7		8		9		10		11		12	
5												
6	16		17		18		15		14		13	
7												
8	19		20		21		22		23		24	
9												
10	30		29		28		27		26		25	
11												
12	31		32		33		34		35		36	
13												

A. Description of original monument and accessories and/or subsequent restoration.  
**ORIGINAL GOVERNMENT SURVEY BY T. WAMPLER, D.S. (1815-1819)**  
 G.L.O. (1819) SET 1/2 MILE POST (DESCRIPTION OF CORNER NOT STATED IN NOTES)  
 WITNESSES: ASH 34 N 79 E 10 (6.60' REC) (GONE)  
 BEECH 30 N 54 W 12 (78.92' REC) (GONE)  
**RESURVEY AT THE DIRECTION OF ALBERT E. CHAMPNEY, DIRECTOR OF WAYNE COUNTY BUREAU OF TAXATION**

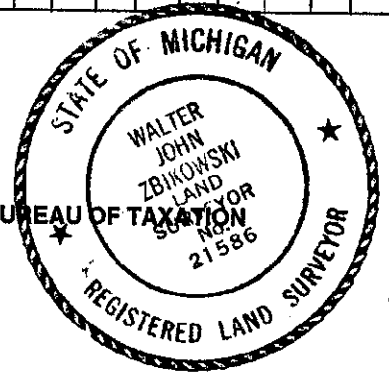

05261591

(CONTINUED ON BACK)

B. Description of corner evidence found and/or method applied in restoring or reestablishing corner.  
 FOUND A FLARED, DETERIORATED 1/2" IRON PIPE BURIED ONE FOOT DEEP IN NORTH BOUND HAGGERTY ROAD (30' WIDE GRAVEL ROAD).  
 DISTANCE TO K-11 TRAVERSED AS 2637.42'; RECORD G.L.O. (1819) DISTANCE OF 40.00 CHAINS (2640.00') RECORD W.P.A. (1930s)  
 DISTANCES OF 2637.52' AND 2637.50'  
 DISTANCE TO K-9 MEASURED AS 2641.82'; RECORD G.L.O. (1819) DISTANCE OF 40.00 CHAINS (2640.00') RECORD W.P.A. (1930s)  
 DISTANCES OF 2641.53' AND 2640.81'  
 DISTANCE TO L-10 TRAVERSED AS 2685.89'; RECORD W.P.A. (1930s) DISTANCE OF 2684.75'

(CONTINUED ON BACK)

C. Description of monument for corner and accessories established to perpetuate locating the position of the corner.  
 K-10 SECTION CORNER 25, 26 T.2S., R.8E.  
 SET CONCRETE MONUMENT 8"± DEEP IN NORTH BOUND HAGGERTY ROAD (A 30' WIDE GRAVEL ROAD) AND IT IS ACCEPTED AS A CAREFUL AND FAITHFUL PERPETUATION OF THE POSITION OF THE ORIGINAL CORNER.  
 WITNESSES: N.54°55'E. 68.43' "X" CUT IN NORTH RIM OF MICHIGAN BELL TELEPHONE MANHOLE (SUPRA)  
 N.67°44'E. 81.79' SET NAIL IN WCR WITNESS BRASS TAG ON NORTH SIDE 18" TREE  
 S.42°22'W. 82.00' FOUND PK NAIL IN WCR REFERENCED BRASS TAG ON SOUTHEAST SIDE UTILITY POLE  
 N.55°49'W. 99.48' FOUND PK NAIL IN PLAIN TAG ON NORTH SIDE 36" CATALPA

PLACED A REMONUMENTATION BRASS DISC AND PVC CAP #21586 ON ABOVE CONCRETE MONUMENT K-10.

Signed by Walter J. Zbikowski Date Dec. 6, 1995  
 Surveyor's Michigan License No. 21586

4  
10 L

## SECTION A (CONTINUED)

W.P.A. (1930s) IRON SET OVER STAKE W-25 (#128)

WITNESSES:	NE	63.13	24" ELM (GONE)
	E	46.92	24" OAK (GONE)
	SE	39.82	DETROIT EDISON POLE (GONE)
	W	62.58	FENCE POST (GONE)

LIBER 28448 PAGE 907

W.C.R.C (1973) IRON W-25 (#128)

WITNESSES:	NE	63.83	"X" CUT IN W RIM OF MICHIGAN BELL TELEPHONE MH (MEASURED 63.77)
	SW	88.38	6" ELM (GONE)
	NW	107.29	DETROIT EDISON POLE (GONE)

## SECTION B (CONTINUED)

L.20402 P.904 FOUND 1/2" IRON PIPE (1978) LCRC #640

N.31°E.	26.77'	BASE BENT NAIL E SIDE MAIL BOX (GONE)
N.59°E.	65.43'	"X" (CUT) NORTH RIM MICHIGAN BELL TELEPHONE MH (MEASURED 65.43)
N.61°E.	64.07'	"X" (CUT) SOUTH RIM MICHIGAN BELL TELEPHONE MH (MEASURED 64.06)
N.74°W.	85.08'	PK NAIL NORTH SIDE 12" TREE (GONE)
N.37°W.	107.36'	NAIL EAST SIDE DETROIT EDISON POLE (GONE)

L.23835 P.354 1/2" IRON ROD (1987) LCRC #919

N.59°E.	65.43'	"X" (CUT) IN NORTH RIM OF MICHIGAN BELL TELEPHONE MH (MEASURED 65.43)
N.61°E.	64.07'	"X" (CUT) IN SOUTH RIM OF MICHIGAN BELL TELEPHONE MH (MEASURED 64.06)
S.85°E.	74.88'	NAIL AND TAG IN 6" ELM (GONE)
S.75°W.	43.60'	NAIL AND TAG NORTH SIDE 10" ELM (GONE)
N.74°W.	85.15'	NAIL AND TAG SOUTH SIDE 18" CRABAPPLE (GONE)

L.26633 P.147 FOUND IRON PIPE (1992) LCRC #1076

N.70°E.	82.05'	PK NAIL (PLAIN AND SUNKEN) NORTH FACE 15" TREE (MEASURED 81.79)
EAST	57.90'	FOUND IRON PIPE #30081 M.C.D. (NOW CONCRETE MONUMENT) (MEASURED 57.98)
S.30°W.	88.46'	PK NAIL IN SE FACE OF 12" TREE (GONE)
S.80°W.	43.45'	FOUND NAIL SE FACE OF 9" TREE (GONE)
N.40°W.	107.72'	FOUND PK NAIL SW FACE OF UTILITY POLE (GONE)