

FEB 28 2000

LAND CORNER RECORDATION CERTIFICATE
Filing Requirement of Act 74, Mich. P.A.1970

SECTION

FILE DO NOT MAIL

For corners in

WAYNE
(County)

Located In: CANTON

Corner Code # K-11

Liber-30821 Page-54
99588885 12/22/1999
F.E. Youngblood, Wayne Co. Register of Deeds
RDANDSYL

- 1. Public Land Survey T 2S R 8E CANTON TWPI(07)
 T _____ R _____
 T _____ R _____
 T _____ R _____
- 2. Property Controlling S _____ T _____ R _____
 in Section S _____ T _____ R _____
- 3. Miscellaneous S _____ T _____ R _____
 Property in Sec. S _____ T _____ R _____

Compliance with
ACT 345, P.A. 1990

APPROVED ON: 12-10-99
WAYNE COUNTY REMONUMENTATION
PEER GROUP COMMITTEE

Register of Deeds Stamp & File
Number

- 4. Lot No. _____, Recorded Plat _____
- 5. Private Claims _____

I, **PETER P. PALCZYNSKI, P.S.** in a field survey on 1 DEC, 19 99 do hereby state that under requirements of P.A. 74, Michigan P.A. of 1970, the corner points mentioned in lines 1 and 2 above were in conformance with regulations and rules therefore as required in the current manual of survey instructions of the United States Department of the Interior, Bureau of Land Management or by a decree of a Court of Law and /or that the corner points mentioned in lines 3, 4 and 5 above were in conformance with the rules of the Michigan Board of Land Surveyors or by a Decree of a Court of Law; established, re-established, monumented, recovered, found as expressed below:

NOTE: Not more than 2 corners, all in the same town and range, may be recorded on this certificate.

A. Description of original monument and accessories and/or subsequent restoration: **K-11**
1816 GLO: WHITE WALNUT 30" DO COR WITNESSES: NOT LISTED
JOSEPH FLETCHER
SEE BACK OF THIS SHEET (NEXT PAGE)
FOR CONTINUATION OF SECTION "A"

B. Description of corner evidence found and/or method applied in restoring or reestablishing corner: **K-11**
FD EMPTY MON BOX @ HAGGERTY RD (53' WD CONC PVT), N OF MICHIGAN AVE. SET 1/2" STEEL BAR IN CONCRETE MONUMENT WITH WCR ALUMINUM CAP STAMPED "PPP-PS 30096" ON 1/2" STEEL BAR IN CONC MON / MON BOX.
CORNER POSITION VERIFIED USING COMPARISONS TO RECORD INFORMATION FROM SECTION "A".

MEASURED:

- K-11 / K-10 = 2637.33 (2637.52 WTA REMON / 2637.52 WPA)
- K-11 / L-11 = 2671.70 (2671.66 WTA REMON/ 2671.67 WPA)
- K-11 / K-12 = 2637.50 (2637.15 / 2637.38 WPA)
- K-11 / J-11 = 2612.26 (2612.36 WTA REMON / 2612.35 WPA)
- K-10 / K-11/ L-11 = 89 53' 33" (89 54' 10" WPA)
- L-11 / K-11/ K-12 = 90 03" 02" (90 04' 00" WPA)
- K-12 / K-11/ J-11 = 90 10' 55" (90 10' 00" WPA)
- J-11 / K-11/ K-10 = 89 52' 30" (89 51' 05" WPA)

C. Description of monument for corner and accessories established to perpetuate locating the position of the corner: **K-11**
FD EMPTY MON BOX @ HAGGERTY RD (53' WD CONC PVT), N OF MICHIGAN AVE. SET 1/2" STEEL BAR IN CONCRETE MONUMENT WITH WCR ALUMINUM CAP STAMPED "PPP-PS 30096" ON 1/2" STEEL BAR IN CONC MON / MON BOX.


- FD NAIL/WCRC REF PT TAG IN SE FACE 14" ELM N42E 114.72'
- CUT "X" IN W RIM OF CATCH BASIN N70E 50.50'
- SET NAIL/WCR TAG IN SW FACE UTILITY POLE S45E 118.31'
- SET NAIL/WCR TAG IN W FACE UTILITY POLE S23E 112.30'
- SET NAIL/WCR TAG IN W FACE UTILITY POLE S22W 132.40'
- SET NAIL/WCR TAG IN NW FACE UTILITY POLE S40W 187.16'
- SET NAIL/WCR TAG IN S FACE UTILITY POLE S84W 51.21'
- CUT "X" IN S RIM GV& W MANHOLE N89W 42.36'
- CUT "X" IN S RIM STORM MANHOLE N80W 59.24'
- CUT "X" IN SE RIM OF CATCH BASIN N63W 27.20'
- FIRE HYDRANT STEM(22)(R=62.85') N39W 62.89'

SELECTED LOCATION IS ACCEPTED BY THE CONTRACTOR AND IS GENERALLY ACCEPTED BY PROFESSIONAL SURVEYORS AS THE BEST AVAILABLE EVIDENCE OF THE POSITION OF THE ORIGINAL CORNER.

Signed by _____
Surveyor's Michigan License No. 30096

Date 1 DEC 99

2S8EK-11.DOC

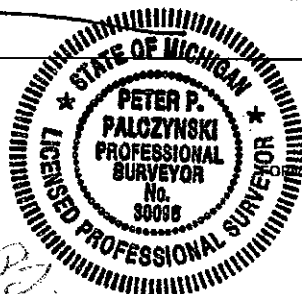

R LCR 12 42.2 pg 1
2001

1999 WAYNE COUNTY REMONUMENTATION PROGRAM

Continuation of Section "A"

History compiled by:
Peter P. Palczynski, P.S. # 30096
AMBIT LAND SURVEYORS, INC.

CANTON TOWNSHIP TOWN 2 SOUTH, RANGE 8 EAST
K-11 (SECTION CORNER 25, 26, 35 & 36)

DATE	COMPANY SURVEYOR JOB #	P.S. #	P.A. 74 L.C.R.C.	LOCATION OF SURVEY	MONUMENT DESCRIPTION	WITNESSES	BEARING & DISTANCE	ID #	COMMENT
1816 1930'S	G.L.O JOSEPH FLETCHER W.P.A.			SECTION	WH WALNUT 30" DO COR IRON (NW-36 #133)	NOT LISTED 8" ASH ED POLE 8" ELM N EDGE PVT TEL POLE DE POLE	NE 85.30' NE 69.87' SE 12.29' S 20.13' W 63.35' NW 73.90'	1 2 3 4 5 6	NOTES = 80.00 CHAINS GONE GONE GONE GONE GONE GONE W.P.A. RECORD: K-11 / K-10 = 2637.52' / 2637.50' K-11 / L-11 = 2671.66' / 2671.67' K-11 / K-12 = 2637.15' / 2637.38' K-11 / J-11 = 2612.35' / 2611.95' K-10 / K-11 / L-11 = 89 53' 33" L-11 / K-11 / K-12 = 90 03' 02" K-12 / K-11 / J-11 = 90 10' 55" J-11 / K-11 / K-10 = 89 52' 30"
1970	WCRS SECTION CORNER WITNESS RECORD			NW CORNER SEC 36 T2S R8E	IRON	PBM N EDGE PVT MBT POLE 16" ASH	SE 93.80' S 20.13' NW 73.90' NW 99.18'	7 8 9 10	GONE GONE GONE GONE
1979	DANIEL SANDMIERSKI RLS	#24616	RC 638 L20402 P902	K-11 T2S R8E	FOUND 1" IRON PIPE	PK NAIL S 6" ELM PK NAIL N EDGE PVT PK NAIL N EDGE PVT REF NAIL W MBT POLE NAIL E 16" ELM	N85E 85.10' S85E 61.50' S56E 67.88' N26W 74.04' N12W 99.10'	11 12 13 14	GONE GONE GONE GONE
1987	GLENN R. HOBGOOD RLS	#21571	RC 920 L.23835 P.355	K-11 T2S R8E	FOUND 1 1/2" IRON ROD IN MON BOX	NAIL / TAG POLE NE COR C B RIM NAIL / TAG MBT POLE NW COR CB RIM	W 53.65' N50W 31.00' N23W 74.00' N35E 51.56'	15 16 17 18 19	GONE GONE GONE GONE GONE
1994	EDWARD O'ROURKE PS	#16937	L.27797 P.642	L-11 T2S R8E - RC 1497	N/A	N/A	N/A		K-11 / L-11 = 2671.67'
1995	WAL J ZBIKOWSKI RLS	#21586	L.28448 P. 900	K-10 T2S R8E - LCRC	N/A	N/A	N/A		K-11 / K-10 = 2637.42'
1996	WAL J ZBIKOWSKI RLS	#21586	L.29337 P.569	J-11 T2S R8E - LCRC	N/A	N/A	N/A		K-11 / J-11 = 2612.36'
1997	WCRS WITNESSES			K-11 T2S R8E	NOT STATED	JOINT WB US-12 DE POLE FIRE HYDRANT DE POLE	SE 21.30' W 53.93' NW 62.85' NW 74.11'	20 21 22 23	GONE GONE M = 62.89' GONE

FEB 28 2000

SECTION