

SURVEY & REMONUMENTATION

APR 25 1995

RC 1502

COMMISSION

LAND CORNER RECORDATION CERTIFICATE
Filing Requirement of Act 74, Mich. P.A. 1970

For corners in

Table with columns: WAYNE (County), Located in: TOWNSHIP OF CANTON #07, Corner Code #. Rows include Public Land Survey, Property Controlling in Section, and Miscellaneous Property in Sec.

L127797PA652

Compliance with ACT 345, P.A. 1990

APPROVED ON: 12-7-94
WAYNE COUNTY REMONUMENTATION PEER GROUP COMMITTEE

Register of Deeds Stamp & File Number

RC 1502

- 4. Lot No. , Recorded Plat
5. Private Claims

Grid table with columns A-M and rows 2-13. Contains numerical values for recording purposes.


I, E. PATRICK O'ROURKE, in a field survey on NOVEMBER 18, 1994, do hereby certify that under requirements of P.A. 74, Michigan P.A. of 1970, the corner points mentioned in lines 1 and 2 above were in conformance with regulations and rules therefore as required in the current manual of survey instructions of the United States Department of the Interior, Bureau of Land Management or by a decree of a Court of Law and/or that the corner points mentioned in lines 3, 4 and 5 above were in conformance with the rules of the Michigan Board of Land Surveyors or by a Decree of a Court of Law, established, re-established, monumented, re-monumented, recovered, found as expressed below:

NOTE: Not more than 4 corners, all in the same town and range, may be recorded on this certificate.

A. Description of original monument and accessories and/or subsequent restoration:

ORIGINAL GOVERNMENT SURVEY BY T. WAMPLER, D.S. (1815-1819)
G.L.O. (1816) DESCRIPTION OF CORNER NOT STATED IN NOTES
WITNESSES: ELM 24 S 25 E 2 (1.32' R) (GONE)
ASH 7 N 40 W 13 (8.58' R) (GONE)
RESURVEY AT THE DIRECTION OF ALBERT E. CHAMPNEY, DIRECTOR OF WAYNE COUNTY BUREAU OF TAXATION
(CONTINUED ON BACK)

B. Description of corner evidence found and/or method applied in restoring or reestablishing corner:
FOUND 3/8" RE-ROD IN CONCRETE MONUMENT IN ROAD BOX IN LEFT TURN LANE OF FORD ROAD PAVEMENT.
DISTANCE TO M-4 TRAVERSED AS 2634.17'; RECORD WPA (1930) DISTANCE AS 2634.02'
DISTANCE TO L-5 MEASURED AS 2716.08'; RECORD WPA (1930) DISTANCES AS 2716.25' AND 2715.50'
L.C.R.C. #373 L.18965 P.485 MONUMENT BOX WITH 3/4" PIPE
N 40 W 43.26' TELEPHONE POLE (GONE)
N 25 E 42.43' TOP CENTER OF FIRE HYDRANT (GONE)
S 15 W 49.80' TOP CENTER OF FIRE HYDRANT (GONE)
L.C.R.C. #612 L.20224 P.533 FOUND 1/2" IRON PIPE IN MONUMENT BOX
N 45°W 45.13' NAIL IN TELEPHONE POLE (GONE)
N 2°W 32.00' NAIL IN 5" ELM (GONE)
S 55°W 62.78' NAIL IN POWER POLE (GONE)
NORTH 15.2' NORTH EDGE PAVEMENT (GONE)
NO OTHER L.C.R.C. ON RECORD AT WAYNE COUNTY REGISTER OF DEEDS

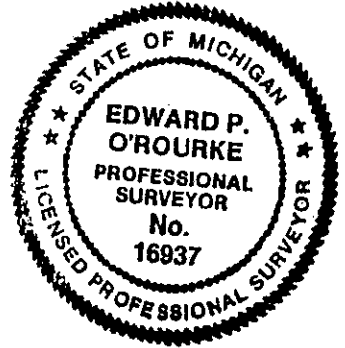

C. Description of monument for corner and accessories established to perpetuate locating the position of the corner:
M-5, SOUTHEAST CORNER SECTION 12, NORTHEAST CORNER SECTION 13, T.2S, R.8E
FOUND 3/8" RE ROD IN CONCRETE MONUMENT BOX IN LEFT TURN LANE OF FIVE LANE FORD ROAD PAVEMENT, AND IS ACCEPTED AS A CAREFUL AND FAITHFUL PERPETUATION OF THE ORIGINAL CORNER.
WITNESSES: N 45°29' E 75.14 CHISLED "X" IN EAST RIM STORM MANHOLE
S 55°14' E 80.00 NORTHWEST BOLT BASE OF STORE LIGHT POLE
S 29°29' W 62.54 CENTERLINE TOP FIRE HYDRANT
N 15°49' W 52.47 CHISLED "X" IN EAST RIM STORM MANHOLE
PLACED A REMONUMENTATION BRASS TAG AND CAP #16937 ON RE-ROD.

\$ 16.00 MISCELLANEOUS RECORDING
27 DEC 94 11:03 A.M. RECEIPT# 40A
RECORDED
FOREST E. YOUNGBLOOD, REGISTER OF DEEDS
WAYNE COUNTY, MI

Signed by [Signature]
E. PATRICK O'ROURKE
Surveyor's Michigan License No. 16937

Date 12-27-94

2K
14-1
MIS

LI27797PA653

SECTION A (CONTINUED)

WPA (1930) IRON SE 12 #53

WITNESSES: NORTH 32.65 FENCE POST (GONE)  
NE 33.95 TELEPHONE POLE (GONE)  
SE 90.60 10" ELM (GONE)  
SOUTH 45.34 10" ELM (GONE)  
SW 60.20 EDISON POLE (GONE)  
NW 79.10 8" ELM (GONE)  
NW 29.90 TWIN 4" ELM (GONE)