

SURVEY & REMONUMENTATION

APR 05 1996

LAND CORNER RECORDATION CERTIFICATE
 Filing Requirement of Act 74, Mich. P.A. 1970

LIBER 28448 PAGE 90

For corners in **COMMISSION**

\$ 4.00 REMONUMENTATION
 \$ 10.00 DEED
 7 DEC 95 11:08 A.M. RECEIPT
 RECORDED
 FOREST E. YOUNGBLOOD, REGISTER
 WAYNE COUNTY, MI

WAYNE

(County)	Located in:	Corner Code #
1. Public Land Survey	TOWNSHIP OF CANTON #07 T2S R8E	M-7
	T R	
	T R	
	T R	
2. Property Controlling in Section	S T R	
	S T R	
3. Miscellaneous Property in Sec.	S T R	
	S T R	
4. Lot No. _____	Recorded Plat _____	
5. Private Claims _____		

Compliance with
 ACT 345, P.A. 1990
 APPROVED ON: 12-4-95
 WAYNE COUNTY REMONUMENTATION
 PEER GROUP COMMITTEE
 Register of Deeds Stamp & File Number

	A	B	G	D	E	F	G	H	I	J	K	L	M
2	8			6				4		3			1
3													
4	7			8				9		10			12
5													
6	18			17				16		15			13
7													
8	19			20				21		22			24
9													
10	30			29				28		27			25
11													
12	31			32				33		34			36
13													

I, **WALTER J. ZBIKOWSKI**, in a field survey on **SEPTEMBER 14, 1995**, do hereby certify that under requirements of P.A. 75, Michigan P.A. of 1970, the corner points mentioned in lines 1 and 2 above were in conformance with regulations and rules therefore as required in the current manual of survey instructions of the United States Department of the Interior, Bureau of Land Management or by a decree of a Court of Law and/or that the corner points mentioned in lines 3, 4 and 5 above were in conformance with the rules of the Michigan Board of Land Surveyors or by a Decree of a Court of Law; established, re-established, monumented, re-monumented, recovered, found as expressed below.

NOTE: Not more than 4 corners, all in the same town and range, may be recorded on this certificate.

A. Description of original monument and accessories and/or subsequent restoration.
ORIGINAL GOVERNMENT SURVEY BY T. WAMPLER, D.S. (1815-1819)

G.L.O. (1816) DESCRIPTION OF CORNER NOT STATED IN NOTES.
 WITNESSES: ASH 14 N 85 W 20 (13.20' R) (GONE)
 ASH 8 N 62 E 25 (16.50' R) (GONE)

RESURVEY AT THE DIRECTION OF ALBERT E. CHAMPNEY, DIRECTOR OF WAYNE COUNTY BUREAU OF TAXATION
 W.P.A. (1930) SET IRON

WITNESSES: NORTH 23.20' IRON (PAVED OVER)
 NNE 43.42' 6" ELM (GONE)
 NE 57.20' TELEPHONE GUY POLE (GONE)
 SE 41.28' TELEPHONE POLE (GONE)
 SW 91.25' TELEPHONE POLE (GONE)

WPA (1950) SET MONUMENT
 WITNESSES: NORTH 23.20' IRON (PAVED OVER)
 NNE 93.81' 20" OAK (GONE)
 NE 93.56' 7" ELM (GONE)
 SE 36.82' TELEPHONE POLE (GONE)
 NW 71.78' 12" ELM (GONE)

B. Description of corner evidence found and/or method applied in restoring or reestablishing corner.
 DISTANCE TO M-8 TRAVERSED AS 2646.11'; RECORD WPA (1930) DISTANCE AS 2643.70'
 DISTANCE TO L-7 MEASURED AS 2697.31'; RECORD WPA (1930) DISTANCE AS 2697.29'
 DISTANCE TO M-8 TRAVERSED AS 2634.48'; RECORD WPA (1930) DISTANCE AS 2633.87'

(CONTINUED ON BACK)

C. Description of monument for corner and accessories established to perpetuate locating the position of the corner.
 M-7 SECTION CORNER 23 24, T.2S., R.8E., REPLACED CONCRETE MONUMENT FOUND UNDER 1/2" IRON PIPE WITH NEW CONCRETE MONUMENT RAISED TO GRADE IN A NEW ROAD BOX IN CENTER OF EAST BOUND CHERRY HILL ROAD (RECENTLY RESURFACED ASPHALT ROAD), AND IT IS ACCEPTED AS A CAREFUL AND FAITHFUL PERPETUATION OF THE POSITION OF THE ORIGINAL CORNER.


WITNESSES:
 N.40°00'E. 67.20' PK NAIL ON SOUTH SIDE GUY POLE (SUPRA)
 S.53°30'E. 60.33' PK NAIL ON NORTHEAST SIDE MICHIGAN BELL TELEPHONE POLE (SUPRA)
 S.54°11'E. 73.28' NAIL IN W.C.R.C. BRASS WITNESS TAG ON SOUTHWEST SIDE OF UTILITY POLE
 S.48°48'W. 102.42' FOUND NAIL IN W.C.R.C. BRASS REFERENCE TAG ON SOUTHEAST SIDE OF UTILITY POLE

NOT A COMMON CORNER.

PLACED A REMONUMENTATION BRASS TAG AND CAP #21586 ON REPLACED CONCRETE MONUMENT.

Signed by Walter J. Zbikowski
 WALTER J. ZBIKOWSKI
 Surveyor's Michigan License No. 21586

Date DEC. 6, 1995

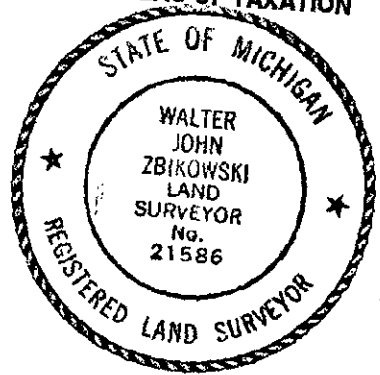

95261592

4
10

- L. 18650 P. 765-766, FOUND IRON PIPE IN HANDHOLE (1973)
 - N.36°14'00"E. 44.62' PK NAIL TOP OF GUARD RAIL POST - 5TH POST FROM END (MEASURED 44.78')
 - S.28°45'00"E. 37.45' PK NAIL IN NORTHEAST SIDE MICHIGAN BELL TELEPHONE POLE (GONE)
 - S.71°08'00"W. 98.67' NAIL WITH CAP IN 24" MAPLE (SOUTH SIDE) (GONE)
 - N.38°12'00"W. 97.97' PK NAIL TOP OF GUARD RAIL, END POST (GONE)

- L. 18650 P. 773-774, IRON PIPE IN HANDHOLE (1973)
 - SAME TIES AS ABOVE
 - WADE-TRIM TIES (NOT RECORDED) ½" IRON PIPE IN MONUMENT BOX (1980)
 - NE 67.20' PK NAIL SOUTH SIDE GUY POLE (MEASURED 67.20")
 - SE 60.43' PK NAIL NORTHEAST SIDE MICHIGAN BELL TELEPHONE POLE (MEASURED 60.33')
 - SSE 27.97' PK NAIL (IN W.C.R.C. BRASS TAG) IN NORTHEAST SIDE 12" TREE (MEASURED 28.02')
 - NW 38.10' VERTICAL PK NAIL IN TOP OF 4" X 4" WOOD POST (WEST END GUARD RAIL) (MEASURED 37.95')