

LAND CORNER RECORDATION CERTIFICATE Filing Requirement of Act 74, Mich. P.A. 1970

APR 05 1996

4.00 REMONUMENTATION
\$ 7.00 DEED
7 DEC 95 11:03 A.M. RECEIPT

For corners in **COMMISSION**

WAYNE (County)	Located in:	Corner Code #
1. Public Land Survey	TOWNSHIP OF CANTON #07 T2S R8E	M-9
2. Property Controlling in Section	S T R	
3. Miscellaneous Property in Sec.	S T R	
4. Lot No. _____, Recorded Plat _____	S T R	
5. Private Claims _____	S T R	

RECORDED
FOREST E. YOUNGLOOD, REGISTER WAYNE COUNTY, MI
Compliance with ACT 345, P.A. 1990
APPROVED ON: 12-4-95
WAYNE COUNTY REMONUMENTATION PEER GROUP COMMITTEE
Register of Deeds Stamp & File Number


I, **WALTER J. ZBIKOWSKI**, in a field survey on **AUGUST 31, 1995**, do hereby certify that under requirements of P.A. 75, Michigan P.A. of 1970, the corner points mentioned in lines 1 and 2 above were in conformance with regulations and rules therefore as required in the current manual of survey instructions of the United States Department of the Interior, Bureau of Land Management or by a decree of a Court of Law and/or that the corner points mentioned in lines 3, 4 and 5 above were in conformance with the rules of the Michigan Board of Land Surveyors or by a Decree of a Court of Law; established, re-established, monumented, re-monumented, recovered, found as expressed below.

NOTE: Not more than 4 corners, all in the same town and range, may be recorded on this certificate.

A	B	C	D	E	F	G	H	I	J	K	L	M
2	6	5	4	3	2	1						
3												
4	7	8	9	10	11	12						
5												
6	18	17	16	15	14	13						
7												
8	23	20	21	22	23	24						
9												
10	30	29	28	27	26	25						
11												
12	31	32	33	34	35	36						
13												

A. Description of original monument and accessories and/or subsequent restoration.

ORIGINAL GOVERNMENT SURVEY BY T. WAMPLER, D.S. (1815-1819)
G.L.O. (1816) DESCRIPTION OF CORNER NOT STATED IN NOTES.
WITNESSES: BEECH 18 S 84 E 14 (9.24 R) (GONE)
BEECH 18 N 52 W 37 (24.42 R) (GONE)
RESURVEY AT THE DIRECTION OF ALBERT E. CHAMPNEY, DIRECTOR OF WAYNE COUNTY BUREAU OF TAXATION
W.P.A. (1930) IRON NE 25 #105
WITNESSES: N 85.36' IRON (MEAS. 86.11')
NE 20.20' 10" ELM (GONE)
SE 16.50' 12" ELM (GONE)
NW 83.24' 24" ELM (GONE)
NW 63.48' 30" ELM (GONE)
W.C.R.C. (1970s) IRON NE 25 #105
N 85.98' IRON (MEAS. 86.11')
SE 24.38' CENTERLINE TOP OF HYDRANT (MEAS. 23.78')
SW 85.60' PROPERTY IRON (GONE)
NW 73.75' DETROIT EDISON POLE (GONE)

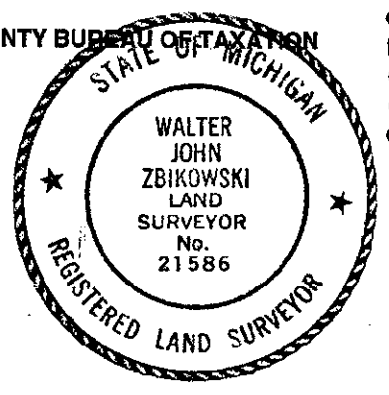

B. Description of corner evidence found and/or method applied in restoring or reestablishing corner.

FOUND 1/2" IRON PIPE OFF EAST EDGE OF NEW ASPHALT PAVEMENT, 3" +/- BELOW SURFACE
DISTANCE TO L-9 MEASURED AS 2707.39'; RECORD WPA (1930) DISTANCES OF 2705.51' AND 2706.65'
DISTANCE TO M-8 TRAVERSED AS 2667.81'; RECORD WPA (1930) DISTANCE OF 2667.89'
DISTANCE TO M-10 MEASURED AS 2648.80'; RECORD WPA (1930) DISTANCE OF 2647.59'
L.C.R.C. #642 L.20402 P.906 FOUND 1/2" IRON PIPE M-9
N 16° E 103.50' NAIL WEST SIDE 6" TREE (GONE)
S 78° E 23.75' CENTERLINE TOP NUT FIRE HYDRANT (MEASURED 23.78')
S 46° W 74.50' PK NAIL EAST SIDE DETROIT EDISON POLE (MEASURED 74.46')
N 22° W 148.70' PK NAIL EAST SIDE DETROIT EDISON POLE (MEASURED 148.99')
NO OTHER L.C.R.C. ON RECORD AT WAYNE COUNTY REGISTER OF DEEDS

C. Description of monument for corner and accessories established to perpetuate locating the position of the corner.

SECTION CORNER 24, 25 T.2S., R.8E., REPLACED THE 1/2" IRON PIPE (BENT) WITH A CONCRETE MONUMENT IN A NEW ROAD BOX FLUSH WITH EAST EDGE OF NEW ASPHALT PAVEMENT OF HANNAN ROAD (JUST SOUTH OF PALMER ROAD), AND IT IS ACCEPTED AS A CAREFUL AND FAITHFUL PERPETUATION OF THE ORIGINAL CORNER.
WITNESSES:
NORTH 86.11' IRON AT SECTION CORNER 19, 30 T.2S, R.9E. (SUPRA)
N.20°38'E. 147.59' PK NAIL IN PLAIN SHINER ON WEST SIDE OF UTILITY POLE
S.78°08'E. 23.83' CENTERLINE OF TOP OF FIRE HYDRANT (SUPRA)
S.46°09'W. 74.15' NAIL IN W.C.R.C. BRASS TAG ON SOUTHEAST SIDE OF UTILITY POLE
N.21°47'W. 149.03' NAIL IN W.C.R.C. BRASS TAG ON EAST SIDE OF UTILITY POLE (SUPRA)
NOT A COMMON CORNER.
PLACE A REMONUMENTATION BRASS DISC AND PVC CAP #21586 ON ABOVE MONUMENT M-9.

Signed by Walter J. Zbikowski
WALTER J. ZBIKOWSKI
Surveyor's Michigan License No. 21586

Date DEC. 6, 1995

95261586

4
7