

SURVEY & MONUMENT

APR 05 1996

LAND CORNER RECORDATION CERTIFICATE \$ 4.00 REMONUMENTATION \$ 10.00 DEED

Filing Requirement of Act 74, Mich. P.A. 1970

7 DEC 95 11:08 A.M. RECEIP

RECORDED FOREST E. YOUNGBLOOD, REGISTER WAYNE COUNTY, MI EDS

LIBER 28448 PAGE 910 Compliance with ACT 345, P.A. 1990

APPROVED ON: 12-4-95 WAYNE COUNTY REMONUMENTATION PEER GROUP COMMITTEE

Register of Deeds Stamp & File Number

For corners in COMMISSION

WAYNE (County)

Located in: TOWNSHIP OF CANTON #07 Corner Code #

- 1. Public Land Survey T2S R8E M-10
2. Property Controlling in Section S T R
3. Miscellaneous Property in Sec. S T R
4. Lot No. Recorded Plat
5. Private Claims

I, WALTER J. ZBIKOWSKI, in a field survey on OCTOBER 5, 1995, do hereby certify that under requirements of P.A. 75, Michigan P.A. of 1970, the corner points mentioned in lines 1 and 2 above were in conformance with regulations and rules therefore as required in the current manual of survey instructions of the United States Department of the Interior, Bureau of Land Management or by a decree of a Court of Law and/or that the corner points mentioned in lines 3, 4 and 5 above were in conformance with the rules of the Michigan Board of Land Surveyors or by a Decree of a Court of Law; established, re-established, monumented, re-monumented, recovered, found as expressed below.

NOTE: Not more than 4 corners, all in the same town and range, may be recorded on this certificate.

A. Description of original monument and accessories and/or subsequent restoration

ORIGINAL GOVERNMENT SURVEY BY T. WAMPLER, D.S. (1815-1819) G.L.O. (1819) POST (DESCRIPTION OF CORNER NOT STATED IN NOTES) WITNESSES: A LYNN 30 S 46 E 9 (5.94' REC) (GONE) A R.O. 5 S 81 W 13 (8.58' REC) (GONE)

RESURVEY AT THE DIRECTION OF ALBERT E. CHAMPNEY, DIRECTOR OF WAYNE COUNTY BUREAU OF TAXATION

(CONTINUED ON BACK)

B. Description of corner evidence found and/or method applied in restoring or reestablishing corner.

FOUND A CONCRETE MONUMENT IN ROAD BOX (GOOD) IN THE CENTERLINE OF HANNAN ROAD (A TWO LANE ASPHALT SURFACED ROAD) JUST SOUTH OF GLENWOOD ROAD. DISTANCE TO M-11 MEASURED AS 2652.25'; RECORD G.L.O. (1819) DISTANCE OF 40.00 CHAINS (2640.00') RECORD W.P.A. (1930s) DISTANCE OF 2652.85' DISTANCE TO M-9 MEASURED AS 2648.67'; RECORD G.L.O. (1819) DISTANCE OF 40.00 CHAINS (2640.00') RECORD W.P.A. (1930s) DISTANCE OF 2647.59' DISTANCE TO L-10 TRAVERSED AS 2690.52'; RECORD W.P.A. (1930's) DISTANCE OF 2692.90' L.20402 P.905 FOUND CONCRETE MONUMENT IN SEC. BOX (1978) LCRC #641 N.30°E. 63.00' CENTERLINE OF TOP NUT OF FIRE HYDRANT (MEASURED 62.85') S.52°E. 42.00' REFERENCE NAIL (WCRC BRASS DISC) IN SW SIDE OF MBT POLE (MEASURED 41.93') S.29°W. 93.63' CENTERLINE OF TOP NUT OF FIRE HYDRANT (MEASURED 93.55') DUE W. 36.40' CENTERLINE OF WOOD FENCE POST (GONE)


C. Description of monument for corner and accessories established to perpetuate locating the position of the corner.

M-10 EAST 1/4 CORNER OF SECTION 25, T.2S., R.8E., A CONCRETE MONUMENT IN ROAD BOX (GOOD) IN THE CENTERLINE OF HANNAN ROAD (A TWO LANE ASPHALT SURFACED ROAD) JUST SOUTH OF GLENWOOD ROAD, AND IT IS ACCEPTED AS A CAREFUL AND FAITHFUL PERPETUATION OF THE POSITION OF THE ORIGINAL CORNER. WITNESSES: N.29°53'E. 62.85' CENTERLINE OF TOP NUT OF FIRE HYDRANT (SUPRA) S.50°39'E. 41.93' NAIL IN WCRC REFERENCE BRASS DISC ON SOUTHWEST SIDE OF UTILITY POLE (SUPRA) S.29°20'W. 93.63' CENTERLINE OF TOP NUT OF FIRE HYDRANT (SUPRA) S.49°26'W. 70.35' SET WCR BRASS WITNESS DISC ON SOUTHEAST SIDE OF 36" MAPLE DUE NORTH 116.99' CONCRETE MONUMENT IN ROAD BOX (SECTION CORNER A-10 WEST OF 30, T.2S., R.9E) M-10, EAST 1/4 CORNER OF SECTION 25, IS NOT COMMON WITH A-10, WEST 1/4 CORNER OF SECTION 30 OF ADJOINING TOWNSHIP (T.2S., R.9E.) TO EAST.

PLACED A REMONUMENTATION BRASS DISC AND PVC CAP #21586 ON ABOVE FOUND CONCRETE MONUMENT M-10.

Signed by Walter J. Zbikowski Surveyor's Michigan License No. 21586

Date Dec. 6, 1995

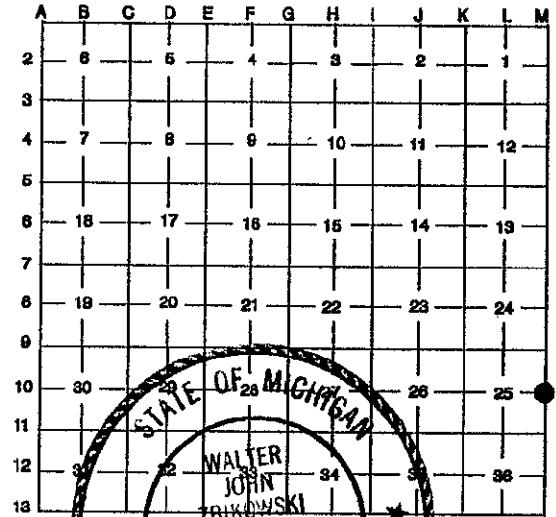

95261593

4 10

SECTION A (CONTINUED)

W.P.A. (1930s) STONE E-30 (#130)

WITNESSES: N. 116.70' STONE (MONUMENT IN ROAD BOX) (MEASURED 116.99')
ENE 21.35' 6" ELM (GONE)
SE 31.47' EDISON POLE (GONE)
NW 25.28' 14" WALNUT (GONE)
NNW 62.40' 48" ELM (GONE)

LIBER 28448 PAGE 911

W.C.R.C. (1970) IRON IN BOX E-25 (#130)

WITNESSES: N 116.70' IRON (MONUMENT IN ROAD BOX) (MEASURED 116.99')
NE 62.88' TOP OF HYDRANT (MEASURED 62.85')
SE 42.01' (NAIL IN WCRC BRASS REFERENCE DISC SOUTHWEST SIDE OF) MBT POLE (MEASURED 41.93')
SW 87.35' (NORTHEAST CORNER OF ALUMINUM SIDING OF HOUSE) #2820 (MEASURED 87.30')