

SURVEY & REMONUMENTATION

DEC 02 1993

RC 1130

COMMISSION

LAND CORNER RECORDATION CERTIFICATE
Filing Requirement of Act 74, Mich. P.A. 1970

L126985 PA 921

For corners in

WAYNE

(County)

Located In:

Corner Code ##

1. Public Land Survey

T 2S R 9E B-3

T _____ R _____

T _____ R _____

T _____ R _____

2. Property Controlling in Section

S _____ T _____ R _____

S _____ T _____ R _____


3. Miscellaneous Property in Sec.

S _____ T _____ R _____

S _____ T _____ R _____

4. Lot No. _____, Recorded Plat _____

5. Private Claims _____

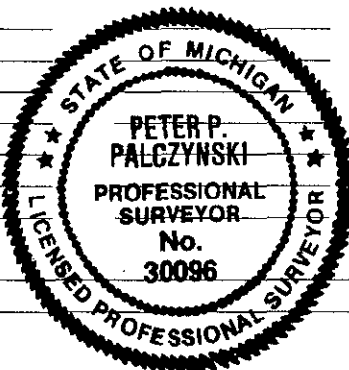

Compliance with ACT 345, P.A. 1990

APPROVED ON: 11/24/93 TCR
WAYNE COUNTY REMONUMENTATION PEER GROUP COMMITTEE

Register of Deeds Stamp & File Number

RC 1130

A	B	C	D	E	F	G	H	I	J	K	L	M
2	6	5	4	3	2	1						
3	7	8	9	10	11	12						
4	7	8	9	10	11	12						
5												
6	18	17	16	15	14	13						
7												
8	19	20	21	22	23	24						
9												
10	30	29	28	27	26	25						
11												
12	31	32	33	34	35	36						
13												

I, P.P. Palczynski, in a field survey on 4 October, 1993

do hereby certify that under requirements of P.A. 74, Michigan P.A. of 1970, the corner points mentioned in lines 1 and 2 above were in conformance with regulations and rules therefore as required in the current manual of survey instructions of the United States Department of the Interior, Bureau of Land Management or by a decree of a Court of Law and/or that the corner points mentioned in lines 3, 4 and 5 above were in conformance with the rules of the Michigan Board of Land Surveyors or by a Decree of a Court of Law; established, re-established, monumented, re-monumented, recovered, found as expressed below:

NOTE: Not more than 4 corners, all in the same town and range, may be recorded on this certificate.

A. Description of original monument and accessories and/or subsequent restoration:

NANKIN TOWNSHIP

G.L.O.- (1830'S) DESCRIPTION OF CORNER MONUMENT NOT STATED IN FIELD NOTES.

WITNESSES LISTED: BEECH 9 S52W 17 (11.2') (GONE) & LYN 12 S62E 13 (8.6') (GONE)

W.P.A.- (1930'S) MON. SET. WITNESSES SHOWN:

6" ELM	E	36.87'	(GONE)
12" ELM	SE	22.00'	(GONE)
12" BEECH	SW	40.5'	(GONE)
POLE	NW	45.6'	(GONE)

C.S.#528 L. 18408, P.289 (4-27-73); C.S.#1018 L.18956, P.715 (11-1-74) W.C.R.

B. Description of corner evidence found and/or method applied in restoring or reestablishing corner:

FOUND 1/2" REROD IN CONC. MON. IN MONUMENT BOX AT CENTERLINE OF HIX ROAD.

MEASURED DISTANCES FOR COMPARISON TO W.P.A. RECORDS:

B-3/B-2: W.P.A. = 2632.20' MEAS. = 2632.29'

C.S. #528: = 2634.39' (4-27-73) L.18408, P.289

C.S. #1018: (CONC. MON IN HAND HOLE) (11-1-74) L.18956, P.715

WITNESSES SHOWN:

P.K. NAIL IN M.B.T. POLE.	N78°E	26.20'	(MEAS. 26.35')
CROSS ON CULVERT	S20°E	73.83'	(MEAS. 73.84')
CROSS ON CULVERT	S20°W	53.03'	(MEAS. 53.06')

C. Description of monument for corner and accessories established to perpetuate locating the position of the corner:

B-3: SECTION CORNER 6 & 7, T2S R9E, FOUND 1/2" REROD/CONC. MON. IN MON. BOX. THE SELECTED LOCATION IS ACCEPTED BY THE CONTRACTOR AND IS GENERALLY ACCEPTED BY PROFESSIONAL SURVEYORS AS THE BEST AVAILABLE EVIDENCE OF THE POSITION OF THE ORIGINAL CORNER. PLACED W.C. REMON. BRASS MARKER AND CAP "PPP PS 30096".

FOUND PK NAIL/WCRC REF PT TAG IN SOUTH FACE UTILITY POLE. N88°E 26.35'

SET NAIL/WCR TAG IN NORTHEAST FACE OF 20" MAPLE. S60°E 77.26'

FOUND CUT CROSS ON CULVERT. S20°E 73.84'

SET NAIL/WCR TAG IN EAST FACE UTILITY POLE. S20°W 103.22'

FOUND NAIL IN CUT CROSS ON CULVERT. S20°W 53.03'

SET NAIL/WCR TAG IN SOUTH FACE UTILITY POLE. N88°W 33.73'

Signed by [Signature]

Date 15 NOVEMBER 1993

Surveyor's Michigan License No. 30096

*2L
11K D*