

RF
FEB 28 2000

LAND CORNER RECORDATION CERTIFICATE
Filing Requirement of Act 74, Mich. P.A.1970

SECTION

FILE DO NOT MAIL

For corners in

WAYNE
(County)

Located in: WESTLAND

Corner Code # C-4

Liber-30821 Page-61
99588891 12/22/1999
F.E. Youngblood, Wayne Co. Register of Deeds
RDANDSYL

- | | | |
|------------------------------------|-------------------------|-----------------------|
| 1. Public Land Survey | T <u>2S</u> R <u>9E</u> | <u>NANKIN TWP(08)</u> |
| | T _____ R _____ | _____ |
| | T _____ R _____ | _____ |
| | T _____ R _____ | _____ |
| 2. Property Controlling in Section | S _____ T _____ R _____ | _____ |
| | S _____ T _____ R _____ | _____ |
| 3. Miscellaneous Property in Sec. | S _____ T _____ R _____ | _____ |
| | S _____ T _____ R _____ | _____ |

Compliance with
ACT 345, P.A. 1990

APPROVED ON: 12-10-99

WAYNE COUNTY REMONUMENTATION
PEER GROUP COMMITTEE

Register of Deeds Stamp & File
Number

4. Lot No. _____, Recorded Plat _____
5. Private Claims _____

I, PETER P. PALCZYNSKI, P.S. in a field survey on 30 NOV, 19 99 do hereby state that under requirements of P.A. 74, Michigan P.A. of 1970, the corner points mentioned in lines 1 and 2 above were in conformance with regulations and rules therefore as required in the current manual of survey instructions of the United States Department of the Interior, Bureau of Land Management or by a decree of a Court of Law and /or that the corner points mentioned in lines 3, 4 and 5 above were in conformance with the rules of the Michigan Board of Land Surveyors or by a Decree of a Court of Law; established, re-established, monumented, recovered, found as expressed below:

	A	B	C	D	E	F	G	H	I	J	K	L	M		
1															
2	6			5			4			3			2	1	
3															
4	7						8			9			10	11	12
5															
6	10			17			16			15			14		13
7															
8	19			20			21			22			23		24
9															
10	30			29			28			27			26		25
11															
12	31			32			33			34			35		36
13															

NOTE: Not more than 2 corners, all in the same town and range, may be recorded on this certificate.

A. Description of original monument and accessories and/or subsequent restoration: C-4
1816 GLO: SET POST B.O. 9" S22W 10 LKS.
JOSEPH FLETCHER D.O. 6" S37E 120 LKS

SEE BACK OF THIS SHEET (NEXT PAGE)
FOR CONTINUATION OF SECTION "A"

B. Description of corner evidence found and/or method applied in restoring or reestablishing corner: C-4
FD 1/2" STEEL BAR IN MON BOX @ CENTERLINE OF NEWBURGH RD. (SOUTH OF WARREN RD) (64' WIDE CONCRETE PAVEMENT WITH CONC CURBS.) REPLACED STEEL BAR WITH WCR ALUMINUM CAP STAMPED "PPP-PS 30096" ON 1/2" STEEL BAR IN CONC MON / MON BOX.
CORNER POSITION VERIFIED USING COMPARISONS TO RECORD INFORMATION FROM SECTION "A".

MEASURED:
C-4 / C-3 = 2626.01 (2626.44 / 2626.88 WPA) C-3 / C-4 / D-4 = 90 39' 32" (90 40' 10" WPA)
C-4 / D-4 = 2584.66 (2584.32 WPA) D-4 / C-4 / C-5 = 89 33' 01" (89 32' 20" WPA)
C-4 / C-5 = 2619.22 (2619.61 / 2619.31 WPA) C-5 / C-4 / B-4 = 89 44' 13" (N/A WPA)
C-4 / B-4 = 2618.47 (N/A WPA) B-4 / C-4 / C-3 = 90 03' 14" (N/A WPA)
C-5 / C-4 / C-3 = 179 47' 27" (179 48' 00" WPA)

C. Description of monument for corner and accessories established to perpetuate locating the position of the corner: C-4
FD 1/2" STEEL BAR IN MON BOX @ CENTERLINE OF NEWBURGH RD. (SOUTH OF WARREN RD) (64' WIDE CONCRETE PAVEMENT WITH CONC CURBS.) REPLACED STEEL BAR WITH WCR ALUMINUM CAP STAMPED "PPP-PS 30096" ON 1/2" STEEL BAR IN CONC MON / MON BOX.


SET NAIL/WCR TAG IN SE FACE UTILITY POLE(6)(R=46.33)	N48E	46.27'
SET NAIL/WCR TAG IN N FACE UTILITY POLE	S89E	50.96'
CENTERLINE OF FIRE HYDRANT STEM	S50E	62.36'
SET NAIL/WCR TAG IN SW FACE 16" PINE	S68W	64.11'
SET NAIL/WCR TAG IN S FACE UTILITY POLE(5)(R=59.68)	N89W	59.69'
SET NAIL/WCR TAG IN NE FACE OF 43" TRIPLE MAPLE	N14W	253.60'

SELECTED LOCATION IS ACCEPTED BY THE CONTRACTOR AND IS GENERALLY ACCEPTED BY PROFESSIONAL SURVEYORS AS THE BEST AVAILABLE EVIDENCE OF THE POSITION OF THE ORIGINAL CORNER.

Signed by [Signature]
Surveyor's Michigan License No. 30096

Date 1 DEC 99

2S9EC-4.DOC

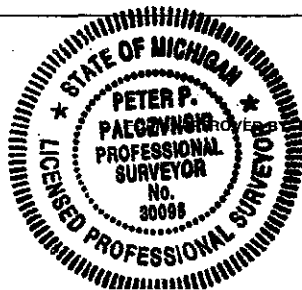

MICHIGAN STATE BOARD OF PROFESSIONAL SURVEYORS, JAN. 28, 1971
REVISED MAY 14, 1975
REVISED JAN., 1983
REVISED OCT., 1986

R LCR 12 4R 2 Pg A
DPZ

1999 WAYNE COUNTY REMONUMENTATION PROGRAM

Continuation of Section "A"

NANKIN TOWNSHIP TOWN 2 SOUTH, RANGE 9 EAST
C-4 (SECTION CORNER 7 & 8)

History compiled by:
Peter P. Palczynski, P.S. # 30096
AMBIT LAND SURVEYORS, INC.

DATE	COMPANY SURVEYOR JOB #	P.S. #	P.A. 74 L.C.R.C.	LOCATION OF SURVEY	MONUMENT DESCRIPTION	WITNESSES	BEARING & DISTANCE	ID #	COMMENT
1816	G.L.O. JOSEPH FLETCHER				SET POST	B.O. 9"	S22°W 10 LKS		NOTES = 40.00 CHAINS
1930'S	W.P.A.				MON (W-8 #42)	D.O. 6" ED POLE MON 12" MAPLE #6405 PORCH	S37E 120 LKS NE 46.62' E 33.12' SE 49.86' SW 85.02'	1 2 3 4	GONE GONE GONE M = 85.19'
1921	WS PARKER CE			SE 1/4 SECTION 7 T2S R 9E	NOT STATED	NOT STATED	NOT STATED		W.P.A. RECORD: C-4 / C-3 = 2626.64' / 2626.88' C-4 / D-4 = 2584.32' C-4 / B-4 = N/A WPA C-3 / C-4 / D-4 = 90 40' 10" D-4 / C-4 / C-5 = 89 32' 20" C-5 / C-4 / C-3 = 179 48' 00"
1925	MASON L BROWN REG CIVIL ENGINEER			SW 1/4 SECTION 8 T2S R9E	NOT STATED	NOT STATED	NOT STATED		
1979	TERENCE B CANTRELL RLS	#5782		SE 1/4 SECTION 7 T2S R9E	NOT STATED	NOT STATED	NOT STATED		
1989	DENNIS A GRIGGS RLS	#23511		C-4 T2S R 9E	FOUND IRON IN MON BOX NAIL S POLE FIRE HYDRANT	NAIL/TAG S POLE NAIL S POLE	N84W 59.68' N53E 46.56' S35E 69.77'	5 6 7	M = 59.69' M = 46.33' MOVED

SECTION
FEB 28 2000
H. H. H. & S.

Liber-30B21

Page 162