

SURVEY & REMONUMENTATION

RC 1141

LI 26985 PA 932

DEC 02 1993


COMMISSION

LAND CORNER RECORDATION CERTIFICATE  
Filing Requirement of Act 74, Mich. P.A. 1970

For corners in  
WAYNE  
(County)

Located In: Corner Code #

- 1. Public Land Survey T 2S R 9E C-7
- 2. Property Controlling in Section S T R
- 3. Miscellaneous Property in Sec. S T R
- 4. Lot No. \_\_\_\_\_, Recorded Plat \_\_\_\_\_
- 5. Private Claims \_\_\_\_\_

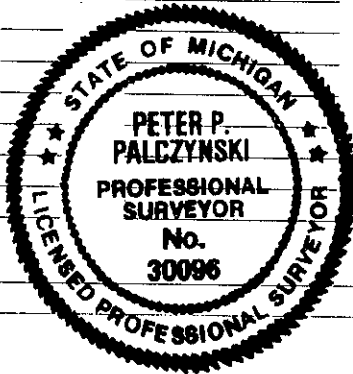

Compliance with ACT 345, P.A. 1990

APPROVED ON: 11/24/93  
WAYNE COUNTY REMONUMENTATION PEER GROUP COMMITTEE

Register of Deeds Stamp & File Number

93 NOV 24 PM 12:08  
 REGISTERED  
 RC 1141

	A	B	C	D	E	F	G	H	I	J	K	L	M
2	6		5		4		3		2		1		
3													
4	7		8		9		10		11		12		
5													
6	18		17		16		15		14		13		
7													
8	19		20		21		22		23		24		
9													
10	30		29		28		27		26		25		
11													
12	31		32		33		34		35		36		
13													

I, P.P. Palczynski, in a field survey on 9 November, 19 93

do hereby certify that under requirements of P.A. 74, Michigan P.A. of 1970, the corner points mentioned in lines 1 and 2 above were in conformance with regulations and rules therefore as required in the current manual of survey instructions of the United States Department of the Interior, Bureau of Land Management or by a decree of a Court of Law and/or that the corner points mentioned in lines 3, 4 and 5 above were in conformance with the rules of the Michigan Board of Land Surveyors or by a Decree of a Court of Law; established, re-established, monumented, re-monumented, recovered, found as expressed below:

NOTE: Not more than 4 corners, all in the same town and range, may be recorded on this certificate.

A. Description of original monument and accessories and/or subsequent restoration:

G.L.O.- (1830'S) DESCRIPTION OF CORNER MONUMENT NOT STATED IN FIELD NOTES.

WITNESSES LISTED: CYPRESS 6 N51W 20 (13.2') (GONE) & DO." 9 N1E 47(31.0') (GONE)

W.P.A.- (1930'S) IRON. WITNESSES SHOWN: ED. POLE NE 53.30' (GONE)

GUY POLE SE 54.03' (GONE) 16" MAPLE SW 77.28' (GONE)

BLDG. COR. SW 54.28' (GONE) 16" TWIN ELM NW 63.29' (GONE)

C.S.#1336 L.19841, P.686(5-1-77) & C.S.#1635, L.20708, P.846(8-16-79). NO L.C.R.C.'S.

B. Description of corner evidence found and/or method applied in restoring or reestablishing corner:

FOUND 1/2" REROD. IN MONUMENT BOX AT NEWBURGH ROAD/CHERRY HILL ROADS.

MEASURED DISTANCES FOR COMPARISON TO W.P.A. RECORDS:

C-7/C-6 W.P.A. = 2640.65' MEAS. = 2640.86'.

WCRC: MON IN BOX-(4-26-72) WITNESS: TOP COR TRAF CONTROL FOUNDTN. NE 77.45' (GONE)

WCRC: MON IN BOX (12-12-74) WITNESS: C.S.#1336 HUB IN BOX (5-1-77) WITNESS:

NAIL/WCRC TAG DE POLE NE 90.80' (GONE) NAIL S/SIDE POLE N60°E 104.31' (GONE)

NAIL/WCRC TAG DE POLE SE 71.37' (M=71.27') T-HYD BOLT S55°E 82.28' (M=82.39')

NAIL/WCRC TAG POLE SW 61.15' (M=60.90') WCRC TAG/POLE S35°W 60.97' (M=60.90')

NAIL/WCRC TAG POLE NW 45.68' (GONE) NAIL SW POLE N38°W 51.65' (M=51.67')

C-7/B-7 W.P.A. = 2598.70' MEAS. = 2598.75'.

C.S.#1635= 2598.77'

C. Description of monument for corner and accessories established to perpetuate locating the position of the corner:

C-7: SECTION CORNER 17,18,19,&20 T2S R9E, FOUND 1/2" REROD IN MONUMENT BOX. THE

SELECTED LOCATION IS ACCEPTED BY THE CONTRACTOR AND IS GENERALLY ACCEPTED BY

PROFESSIONAL SURVEYORS AS THE BEST AVAILABLE EVIDENCE OF THE POSITION OF THE

ORIGINAL CORNER. PLACED W.C.REMON. BRASS MARKER AND CAP "PPP PS 30096".

FOUND P.K. NAIL/WCRC TAG S. FACE UTILITY POLE. N35°E 83.42'

FOUND P.K. NAIL/WCRC TAG N.W. FACE SAME UTILITY POLE. N35°E 83.63'

TOP OF FIRE HYDRANT STEM. S55°E 82.39'

FOUND P.K. NAIL WCRC/TAG IN S.W. FACE UTILITY POLE. S40°E 71.27'

FOUND NAIL/WCRC TAG IN N.W. FACE UTILITY POLE. S35°W 60.90'

FOUND P.K. NAIL/WCRC TAG IN S.W. FACE UTILITY POLE. N40°W 51.67'

Signed by [Signature] Date 15 NOVEMBER 1993

Surveyor's Michigan License No. 30096

2R  
11KD