

SURVEY & REMONUMENTATION

RC 1461

L127795PA296

\$ 13.00 MISCELLANEOUS RECORDING
22 DEC 94 12:01 P.M. RECEIPT# 358

APR 25 1995

LAND CORNER RECORDATION CERTIFICATE
Filing Requirement of Act 74, Mich. P.A. 1970

COMMISSION

For corners in


WAYNE

(County)

Located In:

Corner Code --#

- 1. Public Land Survey T 2S R 9E E-7
- T _____ R _____
- T _____ R _____
- T _____ R _____
- 2. Property Controlling S _____ T _____ R _____
- in Section S _____ T _____ R _____
- 3. Miscellaneous S _____ T _____ R _____
- Property in Sec. S _____ T _____ R _____
- 4. Lot No. _____, Recorded Plat _____
- 5. Private Claims _____

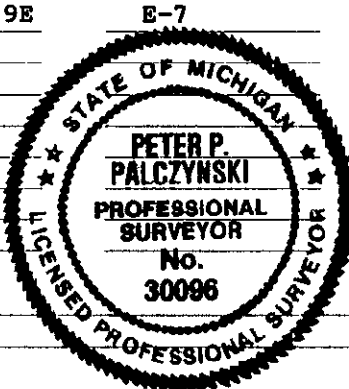

Compliance with
ACT 345, P.A. 1990

APPROVED ON: 11-21-94 *JPJ*
WAYNE COUNTY REMONUMENTATION
PEER GROUP COMMITTEE

Register of Deeds Stamp & File Number

	A	B	C	D	E	F	G	H	I	J	K	L	M
2	6		5		4		3		2		1		
3													
4	7		8		9		10		11		12		
5													
6	18		17		16		15		14		13		
7													
8	19		20		21		22		23		24		
9													
10	30		29		28		27		26		25		
11													
12	31		32		33		34		35		36		
13													

I, P.P. Palczynski, in a field survey on 7 November, 1994, do hereby certify that under requirements of P.A. 74, Michigan P.A. of 1970, the corner points mentioned in lines 1 and 2 above were in conformance with regulations and rules therefore as required in the current manual of survey instructions of the United States Department of the Interior, Bureau of Land Management or by a decree of a Court of Law and/or that the corner points mentioned in lines 3, 4 and 5 above were in conformance with the rules of the Michigan Board of Land Surveyors or by a Decree of a Court of Law; established, re-established, monumented, re-monumented, recovered, found as expressed below:

NOTE: Not more than 4 corners, all in the same town and range, may be recorded on this certificate.

A. Description of original monument and accessories and/or subsequent restoration:

ORIGINAL G.L.O. SURVEYOR: FLETCHER MAY 27, 1817.

DESCRIPTION OF POST SET FOR CORNER MONUMENT NOT STATED IN FIELD NOTES.

WITNESSES LISTED: BO 12 S 21 E 24 (15.8') (GONE) & DO. "6 N 59 W 6 (4.0') (GONE)

W.P.A.-(1930'S) NW-21 IRON. WITNESSES SHOWN: ED POLE NE 31.85' (GONE)
 CS#311, L18232, P55 CROSS-SIGN SE 40.46' (GONE)
 RC#144, L18232, P66 ELM SW 43.26' (GONE)
 CS#924, L18825, P615 U.S.B.M. NW 66.78' (GONE)
 CS#926, L18825, P617 RC#333, L18825, P619

HANKIN TOWNSHIP

RC 1461

B. Description of corner evidence found and/or method applied in restoring or reestablishing corner:

FOUND 1/2" STEEL BAR IN CONC MON /MON BOX AT WAYNE & CHERRY HILL RDS (ASP PVT)
 E-7/E-6:WPA=2633.48'; MEAS=2633.58'; E-7/F-7:WPA=2641.43'; MEAS=2641.15'
 E-7/E-8:WPA=2632.99'; MEAS=2632.75'; E-7/D-7:WPA=2635.17'; MEAS=2635.06'
 E-6/E-7/F-7:WPA=90°58'30"; MEAS=90°58'14"; F-7/E-7/E-8:WPA=89°07'30"; MEAS=89°07'46"
 E-8/E-7/D-7:WPA=90°02'30"; MEAS=90°02'55"; D-7/E-7/E-6:WPA=89°52'00"; MEAS=89°51'05"
 R.C.#144 L18232, P66 (10-25-72) R.C.#333 L18825, P619 (5-31-74)
 FOUND IRON BAR IN MON BOX MONUMENT IN ROAD BOX
 PK NAIL UTIL POLE N44°W 69.40' (GONE) CL PED SIGNAL NE 63.3' (GONE)
 PK NAIL UTIL POLE S56°E 57.70' (GONE) WCRC NAIL/TAG POLE SE 65.37' (GONE)
 PK NAIL UTIL POLE S44°W 71.90' (GONE) WCRC NAIL/TAG POLE SW 71.40' (MEAS=71.35')
 CL COR FC POST NW 85.4' (GONE)

C. Description of monument for corner and accessories established to perpetuate locating the position of the corner:

E-7:SECTION CORNER 16,17,20&21, T2S R9E, FOUND 1/2" STEEL BAR/CONC MON/MON BOX. THE SELECTED LOCATION IS ACCEPTED BY THE CONTRACTOR AND IS GENERALLY ACCEPTED BY PROFESSIONAL SURVEYORS AS THE BEST AVAILABLE EVIDENCE OF THE POSITION OF THE ORIGINAL CORNER. PLACED W.C.REMON. BRASS MARKER AND CAP "PPP PS 30096".
 SET NAIL/WCR TAG IN SOUTHEAST FACE UTILITY POLE N40°E 67.33'
 FOUND WCRC NAIL/TAG IN NORTHEAST FACE UTILITY POLE S40°E 71.65'
 FOUND STEEL BAR S35°E 76.01'
 FOUND WCRC NAIL/TAG IN SOUTHEAST FACE UTILITY POLE S45°W 71.35'
 CENTERLINE OF WCRC BENCHMARK DISC #80-90A S45°W 77.78'
 FOUND WCRC NAIL/TAG IN SOUTHWEST FACE UTILITY POLE N45°W 71.16'

*2R
11-D. Misc*

Signed by *PP* Date 22 DEC 94

Surveyor's Michigan License No. 30096