

SURVEY & REMONUMENTATION

RC 1462

LI27795PA297

APR 25 1995


\$ 13.00 MISCELLANEOUS RECORDING
 22 DEC 94 11:14 P.M. REGISTER OF DEEDS
 RECEIVED

LAND CORNER RECORDATION CERTIFICATE
Filing Requirement of Act 74, Mich. P.A. 1970

For corners in COMMISSION
WAYNE
 (County)

Located In: Corner Code #/

- 1. Public Land Survey T 2S R 9E G-5
- T _____ R _____
- T _____ R _____
- T _____ R _____
- 2. Property Controlling S _____ T _____ R _____
- in Section S _____ T _____ R _____
- 3. Miscellaneous S _____ T _____ R _____
- Property in Sec. S _____ T _____ R _____
- 4. Lot No. _____, Recorded Plat _____
- 5. Private Claims _____

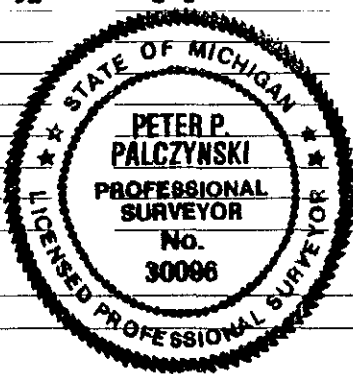

Compliance with
 ACT 345, P.A. 1990
 APPROVED ON: 11-21-94 *DRJ*
 WAYNE COUNTY REMONUMENTATION
 PEER GROUP COMMITTEE
 Register of Deeds Stamp & File Number

P.P. Palczynski in a field survey on 7 November, 19 94,
 do hereby certify that under requirements of P.A. 74, Michigan P.A. of 1970, the corner points mentioned
 in lines 1 and 2 above were in conformance with regulations and rules therefore as required in the
 current manual of survey instructions of the United States Department of the Interior, Bureau of Land
 Management or by a decree of a Court of Law and/or that the corner points mentioned in lines 3, 4 and 5
 above were in conformance with the rules of the Michigan Board of Land Surveyors or by a Decree of a
 Court of Law; established, re-established, monumented, re-monumented, recovered, found as
 expressed below:

A	B	C	D	E	F	G	H	I	J	K	L	M
2	6	5	4	3	2	1						
3												
4	7	8	9	10	11	12						
5												
6	18	17	16	15	14	13						
7												
8	19	20	21	22	23	24						
9												
10	30	29	28	27	26	25						
11												
12	31	32	33	34	35	36						
13												

NOTE: Not more than 4 corners, all in the same town and range, may be recorded on this certificate.

A. Description of original monument and accessories and/or subsequent restoration:

ORIGINAL G.L.O. SURVEYOR: FLETCHER MAY 27, 1817. NANKIN TOWNSHIP
DESCRIPTION OF POST SET FOR CORNER MONUMENT NOT STATED IN FIELD NOTES.
WITNESSES LISTED: MAPLE 12 N 19 E 10 (6.6') (GONE) & POPLAR 6 S 75 E 5 (3.3') (GONE)
W.P.A.-(1930'S) NW-15 IRON. WITNESSES SHOWN:

ED POLE	NE	56.3' (GONE)
ED GUY POLE	SE	65.70' (GONE)
WATER MH	SW	68.35' (GONE)
ED POLE	SW	55.68 (GONE)

NO SUBSEQUENT R.C. OR C.S. FORMS AT WAYNE CO. REGISTER OF DEEDS THIS DATE.

B. Description of corner evidence found and/or method applied in restoring or reestablishing corner:

FOUND 1" IRON PIPE IN MON BOX AT FORD RD / FARMINGTON RD. (ASPHALT PAVEMENT)
MEASURED DISTANCES FOR COMPARISON TO W.P.A. RECORDS:
G-5/F-5: WPA=2627.90'; MEAS=2627.80'; G-5/H-5: WPA=2622.03'; MEAS=2622.70'
H-5/G-5/F-5: WPA=179°12'00"; MEAS=179°11'48"
WCRC SECTION CORNER WITNESS RECORD (2-11-70)
IRON

ED POLE	NE	81.33' (GONE)
CLUMP OF FIVE MAPLES	SE	86.68' (GONE)
ED POLE	SW	64.00' (GONE)
"X" IN KEY WALK FLAG.	N	58.34' (GONE)

C. Description of monument for corner and accessories established to perpetuate locating the position of the corner:

G-5: SECTION CORNER 9, 10, 15 & 16, T2S, R9E, FD 1" IRON PIPE/MON BOX AT FARMINGTON/FORD
THE SELECTED LOCATION IS ACCEPTED BY THE CONTRACTOR AND IS GENERALLY ACCEPTED BY
PROFESSIONAL SURVEYORS AS THE BEST AVAILABLE EVIDENCE OF THE POSITION OF THE
ORIGINAL CORNER. PLACED W.C. REMON. BRASS MARKER AND CAP "PPP PS 30096".

SET "X" IN SOUTHWEST RIM OF STORM MANHOLE.	N05°E	70.74'
CENTERLINE FIRE HYDRANT STEM.	N60°E	96.30'
CUT "X" IN SOUTHEAST BOLT OF LIGHT POLE.	N60°E	100.18'
SET NAIL/WCR TAG IN NORTHEAST FACE UTILITY POLE.	S25°E	179.37'
CENTERLINE OF FIRE HYDRANT STEM.	S30°W	83.22'
CUT "X" IN SOUTHEAST BOLT OF LIGHT POLE.	N75°W	147.04'

*2R
 11-D-MISC*

Signed by *[Signature]* Date 22 DEC 94

Surveyor's Michigan License No. 30096