

SURVEY & REMONUMENTATION

RC 1463

L127795PA298

\$ 13.00 MISCELLANEOUS RECORDING
22 DEC 94 12:01 P.M. RECEIPT# 358

APR 25 1995

LAND CORNER RECORDATION CERTIFICATE
Filing Requirement of Act 74, Mich. P.A. 1970

COMMISSION

For corners in


WAYNE

(County)

Located In:

Corner Code #

- 1. Public Land Survey T 2S R 9E G-7
- T _____ R _____
- T _____ R _____
- T _____ R _____
- 2. Property Controlling S _____ T _____ R _____
- in Section S _____ T _____ R _____
- 3. Miscellaneous S _____ T _____ R _____
- Property in Sec. S _____ T _____ R _____
- 4. Lot No. _____, Recorded Plat _____
- 5. Private Claims _____

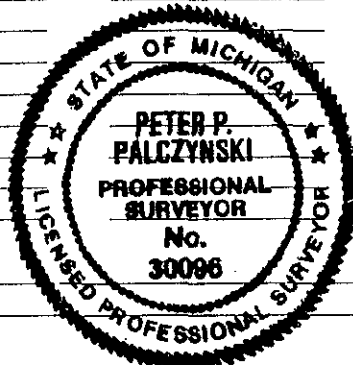

Compliance with
ACT 345, P.A. 1990

APPROVED ON: 11-21-94
WAYNE COUNTY REMONUMENTATION
PEER GROUP COMMITTEE

Register of Deeds Stamp & File Number

	A	B	C	D	E	F	G	H	I	J	K	L	M
2	6		5		4		3		2		1		
3													
4	7		8		9		10		11		12		
5													
6	18		17		16		15		14		13		
7													
8	19		20		21		22		23		24		
9													
10	30		29		28		27		26		25		
11													
12	31		32		33		34		35		36		
13													

I, P.P. Palczynski, in a field survey on 7 November, 1994, do hereby certify that under requirements of P.A. 74, Michigan P.A. of 1970, the corner points mentioned in lines 1 and 2 above were in conformance with regulations and rules therefore as required in the current manual of survey instructions of the United States Department of the Interior, Bureau of Land Management or by a decree of a Court of Law and/or that the corner points mentioned in lines 3, 4 and 5 above were in conformance with the rules of the Michigan Board of Land Surveyors or by a Decree of a Court of Law; established, re-established, monumented, re-monumented, recovered, found as expressed below:

NOTE: Not more than 4 corners, all in the same town and range, may be recorded on this certificate.

A. Description of original monument and accessories and/or subsequent restoration:
ORIGINAL G.L.O. SURVEYOR: FLETCHER MAY 27, 1817.

NANKIN TOWNSHIP

DESCRIPTION OF POST SET FOR CORNER MONUMENT NOT STATED IN FIELD NOTES.

WITNESSES LISTED: W.ASH 9 N 73 W 7 (4.3') (GONE) & DO" 10 N 46 E 7 (4.3') (GONE)

W.P.A.-(1930'S) NW-22 MON SET WITNESSES SHOWN: IRON N 33.28' (GONE)

C.S.#401,L18285,P581-582; 3" ELM NE 33.01' (GONE)

R.C.#165,L18285,P571; 3" ELM NE 81.93' (GONE)

R.C.#450,L19297,P813. 24"MAPLE SE 106.36' (GONE)

HOUSE SE 109.30' (MEAS=109.09)

B. Description of corner evidence found and/or method applied in restoring or reestablishing corner:

FOUND 1/2" IRON IN MON BOX AT CHERRY HILL / FARMINGTON RD. (CONCRETE PAVEMENT)

MEASURED DISTANCES FOR COMPARISON TO W.P.A. RECORDS:

G-7/G-6:WPA=2595.58'; MEAS=2595.76'; G-7/G-8:WPA=2677.65'; MEAS=2677.85'

G-6/G-7/G-8: WPA=179°48'20"; MEAS=179°49'02"

RC#165,L.18285,P571 (11-4-72)

RC #450,L.19297,P813(1-5-76)

NOT STATED

CONCRETE MONUMENT IN MONUMENT BOX

GATE WELL N8°E 62.05' (MEAS=62.09') NAIL/TAG NE 11"ELDER NW 93.85' (GONE)

DE POLE S2°E 50.45' (MEAS=51.28') NAIL/TAG NE 8" ELM NW 69.28' (GONE)

UT. POLE S50°W 63.45' (MEAS=63.33') NAIL/TAG SE 12"MAPLE NE 61.02' (MEAS=61.02)

UT. POLE N35°W 63.30' (GONE) NAIL/TAG W SIDE POLE S 51.32' (MEAS=51.28)

C. Description of monument for corner and accessories established to perpetuate locating the position of the corner:

G-7:SECTION CORNER 15,16,21&22,T2S,R9E,FD 1/2" IRON/MON BOX @FARMNGTN/CHERRY HILL

THE SELECTED LOCATION IS ACCEPTED BY THE CONTRACTOR AND IS GENERALLY ACCEPTED BY PROFESSIONAL SURVEYORS AS THE BEST AVAILABLE EVIDENCE OF THE POSITION OF THE ORIGINAL CORNER. PLACED W.C.REMON. BRASS MARKER AND CAP "PPP PS 30096".

FOUND CUT "X" ON GATE WELL RIM . N08°E 62.09'

FOUND PK NAIL/WCRC TAG IN WEST FACE 15" MAPLE. N30°E 61.02'

FOUND NAIL/WCRC TAG IN WEST FACE UTILITY POLE. S01°W 51.28'

SET NAIL/WCR TAG IN SOUTHEAST FACE UTILITY POLE. S70°W 170.00'

CENTERLINE OF FIRE HYDRANT STEM. N60°W 108.12'

FOUND NAIL/WCRC TAG IN NORTHEAST FACE UTILITY POLE. N35°W 63.33'

Signed by [Signature]

Date 22 DEC 94

Surveyor's Michigan License No. 30096

RC 1463

*2 R
11-0 misc*