

SURVEY & REMONUMENTATION

DEC 02 1993

RC 1139

LI 26985 PA 930

93 NOV 24 PM 12:08
 REGISTERED


COMMISSION

LAND CORNER RECORDATION CERTIFICATE
 Filing Requirement of Act 74, Mich. P.A. 1970

For corners in **WAYNE**
 (County)

Located In: _____ Corner Code # _____

- | | | |
|---------------------------------------|-------------------------|-----|
| 1. Public Land Survey | T <u>2S</u> R <u>9E</u> | I-9 |
| | T _____ R _____ | |
| | T _____ R _____ | |
| | T _____ R _____ | |
| 2. Property Controlling in Section | S _____ T _____ R _____ | |
| | S _____ T _____ R _____ | |
| 3. Miscellaneous Property in Sec. | S _____ T _____ R _____ | |
| | S _____ T _____ R _____ | |
| 4. Lot No. _____, Recorded Plat _____ | | |
| 5. Private Claims _____ | | |

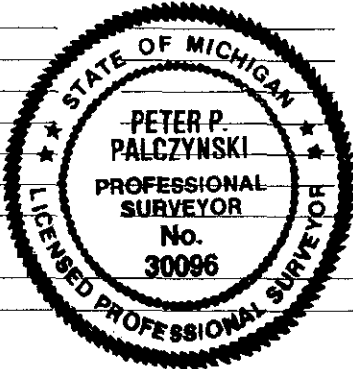

Compliance with ACT 345, P.A. 1990
 APPROVED ON: 11/24/93 TKD
 WAYNE COUNTY REMONUMENTATION PEER GROUP COMMITTEE
 Register of Deeds Stamp & File Number

RC 1139

I, **P.P. Palczynski**, in a field survey on 9 November, 19 93

do hereby certify that under requirements of P.A. 74, Michigan P.A. of 1970, the corner points mentioned in lines 1 and 2 above were in conformance with regulations and rules therefore as required in the current manual of survey instructions of the United States Department of the Interior, Bureau of Land Management or by a decree of a Court of Law and/or that the corner points mentioned in lines 3, 4 and 5 above were in conformance with the rules of the Michigan Board of Land Surveyors or by a Decree of a Court of Law; established, re-established, monumented, re-monumented, recovered, found as expressed below:

NOTE: Not more than 4 corners, all in the same town and range, may be recorded on this certificate.

A	B	C	D	E	F	G	H	I	J	K	L	M
2	6	5	4	3	2	1						
3												
4	7	8	9	10	11	12						
5												
6	18	17	16	15	14	13						
7												
8	19	20	21	22	23	24						
9												
10	30	29	28	27	26	25						
11												
12	31	32	33	34	35	36						
13												

A. Description of original monument and accessories and/or subsequent restoration:

NANKIN TOWNSHIP

G.L.O.- (1830'S) DESCRIPTION OF CORNER MONUMENT NOT STATED IN FIELD NOTES.

WITNESSES LISTED: W.ASH 12 S22E 27 (4.6') (GONE) & ELM 10 N76W 5 (3.3') (GONE)

W.P.A.- (1930'S) IRON. WITNESSES SHOWN:

ED POLE	NE	46.15'	(GONE)
TEL POLE	SE	78.19'	(GONE)
24" ELM	SW	48.00'	(GONE)
12" HICKORY	NW	75.62'	(GONE)

L.C.R.C.#427, L.19117,P.491 & L.C.R.C.#844, L.22114,P.116. NO C.S.'S.

B. Description of corner evidence found and/or method applied in restoring or reestablishing corner:

FOUND 1/2" REROD. IN CONC. MON. IN MONUMENT BOX AT PALMER/MERRIMAN ROADS.

MEASURED DISTANCES FOR COMPARISON TO W.P.A. RECORDS:

I-9/I-8: W.P.A. = 2636.13' MEAS. = 2635.45'

W.C.R.C. WITNESS(3-18-75)MON W/BOX.	R.C.#844,L.22114,P.116(8-17-84)MON IN BOX
SW BOLT LT BASE NE 60.78' (GONE)	SW BOLT CONC BASE N70°E 66.78' (M=66.84')
DE POLE SE 94.86' (GONE)	NW COR CONC BASE. S30°E 78.17' (M=78.47')
NE COR LT BASE SW 88.03' (GONE)	SPIKE/TAG DE POLE S10°E 94.83' (GONE)
SE BOLT LT BASE NW 85.11' (GONE)	NE COR CONC BASE S55°W 95.59' (M=95.30')
RC#427,L.19117,P.491(5-19-75),MON/BOX.	PK NAIL TRFC POLE N50°W 68.05' (GONE)

SAME WITNESSES AS W.C.R.C. ABOVE.

C. Description of monument for corner and accessories established to perpetuate locating the position of the corner:

I-9:SECTION CORNER 22,23,26&27, T2S R9E, FOUND 1/2"REROD/CONC MON IN MON BOX.THE SELECTED LOCATION IS ACCEPTED BY THE CONTRACTOR AND IS GENERALLY ACCEPTED BY PROFESSIONAL SURVEYORS AS THE BEST AVAILABLE EVIDENCE OF THE POSITION OF THE ORIGINAL CORNER. PLACED W.C.REMON. BRASS MARKER AND CAP "PPP PS 30096".

SET NAIL/WCR TAG IN NW FACE UTILITY POLE.	N47°E	70.51'
SW BOLT IN CONCRETE BASE.	N70°E	66.84'
SET NAIL/WCR TAG IN N/W FACE UTILITY POLE.	S45°E	74.53'
SET NAIL/WCR TAG IN SE FACE UTILITY POLE.	S39°W	79.34'
NE CORNER CONCRETE SIGN BASE.	S55°W	95.30'
SET NAIL/WCR TAG IN NE FACE UTILITY POLE.	N29°W	68.08'

Signed by P.P. Palczynski Date 15 NOVEMBER 1993

Surveyor's Michigan License No. 30096

TKD