

REMONUMENTATION  
 FEB 29 1994  
 COMMISSION

RC 1363

LI 27059 PA 137

LAND CORNER RECORDATION CERTIFICATE  
 Filing Requirement of Act 74, Mich. P.A. 1970

For corners in

WAYNE (County)	Located In:	Corner Code ##
1. Public Land Survey	T 2S R 9E	I 12
	T ___ R ___	___
	T ___ R ___	___
	T ___ R ___	___
2. Property Controlling in Section	S ___ T ___ R ___	___
	S ___ T ___ R ___	___
3. Miscellaneous Property in Sec.	S ___ T ___ R ___	___
	S ___ T ___ R ___	___

Compliance with  
 ACT 345, P.A. 1990  
 APPROVED ON: 12-21-93  
 WAYNE COUNTY REMONUMENTATION  
 PEER GROUP COMMITTEE

Register of Deeds Stamp & File Number

4. Lot No. \_\_\_\_\_, Recorded Plat \_\_\_\_\_  
 5. Private Claims \_\_\_\_\_

I, RAPHAEL J. LANDINI in a field survey on NOVEMBER 17, 19 93, do hereby certify that under requirements of P.A. 74, Michigan P.A. of 1970, the corner points mentioned in lines 1 and 2 above were in conformance with regulations and rules therefore as required in the current manual of survey instructions of the United States Department of the Interior, Bureau of Land Management or by a decree of a Court of Law and/or that the corner points mentioned in lines 3, 4 and 5 above were in conformance with the rules of the Michigan Board of Land Surveyors or by a Decree of a Court of Law; established, re-established, monumented, re-monumented, recovered, found as expressed below:

**NOTE: Not more than 4 corners, all in the same town and range, may be recorded on this certificate.**


	A	B	C	D	E	F	G	H	I	J	K	L	M
2	6	5	4	3	2	1							
3													
4	7	8	9	10	11	12							
5													
6	13	17	16	15	14	13							
7													
8	19	20	21	22	23	24							
9													
10	30	29	28	27	26	25							
11													
12	31	32	33	34	35	36							
13													

A. Description of original monument and accessories and/or subsequent restoration:

G.L.O.						
MAPLE	10	S 20 W	23	(15.2)	(GONE)	
LYNN	10	N 70 W	17	(11.2)	(GONE)	
WPA (1930S) STONE						
16" ELM		NE	27.38	(GONE)		
8" CHERRY		SE	26.63	(GONE)		
IRON		SSW	.50	(GONE)		
6" TREE OF HEAVEN		SW	36.21	(GONE)		
16" TREE OF HEAVEN		W	23.60	(GONE)		

B. Description of corner evidence found and/or method applied in restoring or reestablishing corner:

WAYNE COUNTY ROAD COMM. STONE 4-62					
FENCE POST		NE	66.55	(GONE)	
18" ELM		ESE	56.00	(GONE)	
17" TREE OF HEAVEN		W	44.60	(GONE)	
ED POLE		NW	101.35	(GONE)	
WAYNE COUNTY DPS ROADS FOUND 1/2" IRON IN MON BOX 9-88					
WCRC TAG S SIDE DE POLE		E	32.55	(GONE)	
CENTERLINE HYDRANT		SE	114.1	(GONE)	
CENTERLINE HYDRANT		NW	70.36	(MEAS. 70.42)	
WCRC TAG SW SIDE POLE		NW	63.02	(GONE)	

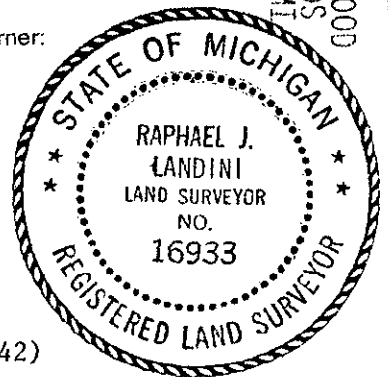

93 DEC 22 AM 10:20  
 FOREST E. YOUNGBLOOD  
 REGISTER OF DEEDS  
 WAYNE COUNTY, MI

C. Description of monument for corner and accessories established to perpetuate locating the position of the corner:

I-12 T 2S R9E  
 STANDARD 4" DIA X 36" CONC. MONUMENT WITH 3/8" IRON ROD; REMON. BRASS DISK WITH CAP RJL RLS 16933 IN MON BOX. SELECTED LOCATION IS ACCEPTED BY CONTRACTOR AND IS GENERALLY ACCEPTED BY PROFESSIONAL SURVEYORS AS THE BEST AVAILABLE EVIDENCE OF THE POSITION OF THE ORIGINAL CORNER.

SET WCRC TAG S SIDE DE POLE	S80°E	52.09'
CUT X NW CORNER WATER GATE RIM	S44°E	64.64'
SET WCRC TAG NW SIDE GUY POLE	S30°W	123.61'
SET WCRC TAG NE SIDE TRAFFIC POLE	N52°W	61.63'
CENTERLINE HYDRANT	N53°W	70.42'

Signed by Raphael J. Landini Date DECEMBER 15, 1993  
 Surveyor's Michigan License No. 16933

22  
 114