

SURVEY & REMONUMENTATION

RC 1466

L127795PA301

APR 25 1995

\$ 13.00 MISCELLANEOUS RECORDING
22 DEC 94 12:03 P.M. RECEIPT# 350
REGISTERED
REGISTER OF DEEDS

LAND CORNER RECORDATION CERTIFICATE
Filing Requirement of Act 74, Mich. P.A. 1970


For corners in **COMMISSION**
WAYNE
(County)

Located In: Corner Code ##

Compliance with
ACT 345, P.A. 1990

APPROVED ON: 11-21-94 JPA
WAYNE COUNTY REMONUMENTATION
PEER GROUP COMMITTEE

- 1. Public Land Survey T 2S R 9E K-5
- T _____ R _____
- T _____ R _____
- T _____ R _____
- 2. Property Controlling S _____ T _____ R _____
- in Section S _____ T _____ R _____
- 3. Miscellaneous S _____ T _____ R _____
- Property in Sec. S _____ T _____ R _____

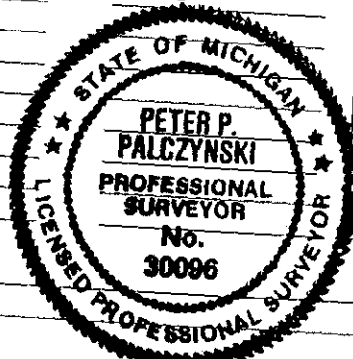

Register of Deeds Stamp & File Number

	A	B	C	D	E	F	G	H	I	J	K	L	M
2	6	5	4	3	2								
3													
4	7	8	9	10	11	12							
5													
6	18	17	16	15	14	13							
7													
8	19	20	21	22	23	24							
9													
10	30	29	28	27	26	25							
11													
12	31	32	33	34	35	36							
13													

I, **P.P. Palczynski**, in a field survey on **7 November**, 19 **94**, do hereby certify that under requirements of P.A. 74, Michigan P.A. of 1970, the corner points mentioned in lines 1 and 2 above were in conformance with regulations and rules therefore as required in the current manual of survey instructions of the United States Department of the Interior, Bureau of Land Management or by a decree of a Court of Law and/or that the corner points mentioned in lines 3, 4 and 5 above were in conformance with the rules of the Michigan Board of Land Surveyors or by a Decree of a Court of Law; established, re-established, monumented, re-monumented, recovered, found as expressed below:

NOTE: Not more than 4 corners, all in the same town and range, may be recorded on this certificate.

A. Description of original monument and accessories and/or subsequent restoration:
ORIGINAL G.L.O. SURVEYOR: FLETCHER MAY 27, 1817.
DESCRIPTION OF POST SET FOR CORNER MONUMENT NOT STATED IN FIELD NOTES.
WITNESSES LISTED: LYNN 9 S 59 W 13 (8.6') (GONE) & DO" 12 N 1 W 9 (5.9') (GONE)
W.P.A. - (1930'S) NW-13 IRON WITNESSES SHOWN: TEL POLE NE 85.97' (GONE)
TEL POLE SE 58.66' (GONE)
WATER GATE SW 70.68' (MEAS=70.73')
WATER GATE NW 77.30' (MEAS=77.40')

NANKIN TOWNSHIP

RC 1466

B. Description of corner evidence found and/or method applied in restoring or reestablishing corner:
FOUND 1/2" STEEL BAR IN CONC MON/MON BOX AT FORD/MIDDLEBELT RDS. (ASP PAVEMENT)
MEASURED DISTANCES FOR COMPARISON TO W.P.A. RECORDS:
K-5/K-4: WPA=2686.16'; MEAS=2685.97'; K-5/L-5: WPA=2599.07'; MEAS=2599.27'
K-5/K-6: WPA=2602.84'; MEAS=2603.20'
K-4/K-5/L-5: WPA=89°28'15"; MEAS=89°28'53" L-5/K-5/K-6: WPA=91°14'30"; MEAS=91°13'49"
RC#371, L18965, P481 (10-14-74) WCRC SEC COR WIT REC (12-6-89) MON IN BOX
MON BOX WITH 1" PIN
"X" NW BOLT ST LAMP N50°E 82.80' (MEAS=82.85')
N40°W 42.65' T POLE (GONE) "X" SW BOLT ST LAMP S63°E 75.61' (GONE)
N45°E 82.65' P POLE (GONE) "X" SE BOLT ST LAMP S53°W 87.45' (MEAS=87.47')
S45°W 61.85' TOP HYD (GONE) "X" SW BOLT ST LAMP N36°W 78.86' (MEAS=78.90')

C. Description of monument for corner and accessories established to perpetuate locating the position of the corner:
K-5: SECTION CORNER 11, 12, 13 & 14, T2S, R9E, FD 1/2" STEEL BAR IN CONC MON/ MON BOX. THE SELECTED LOCATION IS ACCEPTED BY THE CONTRACTOR AND IS GENERALLY ACCEPTED BY PROFESSIONAL SURVEYORS AS THE BEST AVAILABLE EVIDENCE OF THE POSITION OF THE ORIGINAL CORNER. PLACED W.C. REMON. BRASS MARKER AND CAP "PPP PS 30096".
FOUND CUT "X" ON NORTHWEST BOLT OF LIGHT POLE. N50°E 82.85'
FOUND CUT "X" ON NORTHEAST BOLT OF LIGHT POLE. S35°E 80.33'
FOUND CUT "X" ON NORTHWEST BOLT OF LIGHT POLE. S38°W 85.39'
FOUND CUT "X" ON NORTHWEST BOLT OF LIGHT POLE. S52°W 87.47'
CENTERLINE WCRC BRASS DISC BENCHMARK #110-80 N45°W 78.90'
FOUND CUT "X" ON SOUTHWEST BOLT OF LIGHT POLE. N36°W 78.90'

2R
11-D-MISC

Signed by [Signature] Date 22 DEC 94
Surveyor's Michigan License No. 30096