SURVEY &
REMONUMENTATION

APR 2 5 1995

COMMISSION

RC 1467

L127795PA302
$ 15.00 MISCELLANEOUS RECORDING
22 DEC 94 12:03 P.M. RECEIPT# 350
REGISTER OF DEEDS

LAND CORNER RECORDATION CERTIFICATE

Filing Requirement of Act 74, Mich. P.A. 1970

For corners in
WAYNE
(County)

Located In: Corner Code ##

1. Public Land Survey T 2S R 9E K-9
   T ___ R ___
   T ___ R ___
   T ___ R ___
2. Property Controlling S ___ T ___ R ___
   in Section S ___ T ___ R ___
3. Miscellaneous S ___ T ___ R ___
   Property in Sec. S ___ T ___ R ___

Compliance with
ACT 345, P.A. 1990
APPROVED ON: 11-21-94
WAYNE COUNTY REMONUMENTATION
PEER GROUP COMMITTEE

Register of Deeds Stamp & File Number

STATE OF MICHIGAN
PETER P. PALCZYNSKI
PROFESSIONAL SURVEYOR
No. 30096
LICENSED PROFESSIONAL SURVEYOR

4. Lot No. _____, Recorded Plat _____
5. Private Claims _____

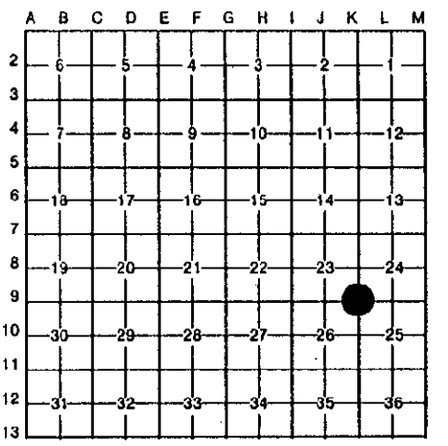

I, P.P. Palczynski, in a field survey on 7 November, 19 94, do hereby certify that under requirements of P.A. 74, Michigan P.A. of 1970, the corner points mentioned in lines 1 and 2 above were in conformance with regulations and rules therefore as required in the current manual of survey instructions of the United States Department of the Interior, Bureau of Land Management or by a decree of a Court of Law and/or that the corner points mentioned in lines 3, 4 and 5 above were in conformance with the rules of the Michigan Board of Land Surveyors or by a Decree of a Court of Law; established, re-established, monumented, re-monumented, recovered, found as expressed below:

NOTE: Not more than 4 corners, all in the same town and range, may be recorded on this certificate.

A. Description of original monument and accessories and/or subsequent restoration:

ORIGINAL G.L.O. SURVEYOR: FLETCHER MAY 27, 1817. NANKIN TOWNSHIP
DESCRIPTION OF POST SET FOR CORNER MONUMENT: NOT STATED IN FIELD NOTES.
WITNESSES: SUG 9 S 51 E, 19(12.5) & DO " 9 N 59 E, 30(19.8)
W.P.A.-(1930'S) IRON ,WITNESSES SHOWN:

ED POLE	NE	55.92'	(GONE)
5" ELM	SE	30.77'	(GONE)
POWER POLE	SW	60.2'	(GONE)
5" ELM	NW	75.8'	(GONE)

NO SUBSEQUENT R.C. OR C.S. FORMS AT WAYNE COUNTY REGISTER OF DEEDS, THIS DATE.

RC 1467

B. Description of corner evidence found and/or method applied in restoring or reestablishing corner:

FOUND 3/4" IRON PIPE IN MONUMENT BOX AT MIDDLEBELT / PALMER ROADS.(CONCRETE PVT)
MEASURED DISTANCES FOR COMPARISON TO W.P.A. RECORDS:
K-9/K-8: W.P.A. = 2637.72' MEAS. = 2638.06'
K-9/J-9: W.P.A. = 2644.19' MEAS. = 2644.73'
J-9/K-9/K-8: W.P.A. = 88° 52' 00" MEAS. = 88° 51' 33"

C. Description of monument for corner and accessories established to perpetuate locating the position of the corner:

K-9:SECTION CORNER 23,24,25,26 T2S R9E FOUND 3/4"IRON PIPE IN MONUMENT BOX.THE SELECTED LOCATION IS ACCEPTED BY THE CONTRACTOR AND IS GENERALLY ACCEPTED BY PROFESSIONAL SURVEYORS AS THE BEST AVAILABLE EVIDENCE OF THE POSITION OF THE ORIGINAL CORNER. PLACED W.C.REMON. BRASS MARKER AND CAP "PPP PS 30096".

CENTERLINE FIRE HYDRANT STEM.	N20°E	165.98'
FOUND CUT "X" IN SOUTHEAST BOLT OF LIGHT POLE BASE.	S80°E	40.74'
SET NAIL/WCR TAG IN NORTHEAST FACE OF UTILITY POLE.	S35°E	92.09'
FOUND CUT "X" IN NORTHEAST BOLT OF LIGHT POLE BASE.	S30°W	81.01'
FOUND CUT "X" IN SOUTHEAST BOLT OF LIGHT POLE BASE.	N25°W	98.54'

2R
11-D-MISC

Signed by _____ Date 22DEC94

Surveyor's Michigan License No. 30096

FORM APPROVED BY MICHIGAN STATE BOARD OF LAND SURVEYORS, JAN. 28, 1971
REVISED MAY 14, 1975
REVISED JAN., 1983