COMMISSION

\$ 13.00 MISCELLANEOUS RECORDING

LAND CORNER RECORDATION CERTIFICATED DEC 94 12:05 P.N.


RECEIPT# 35B

Filing Requirement of Act 74, Mich. P.A. 1970
FOREST E. YOUNGRLOOD, REGISTER OF DEED WAYNE COUNTY, HI

> Compliance with ACT 345, P.A. 1990

APPROVED ON: 11-21-9 WAYNE COUNTY REMONUMENTATION PEER GROUP COMMITTEE

Register of Deeds Stamp & File Number

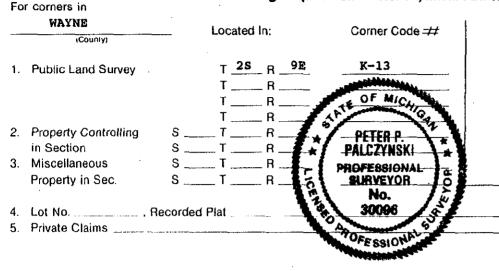

P.P. Palczynski 7 November , in a field survey on . . 19 do hereby certify that under requirements of P.A. 74, Michigan P.A. of 1970, the corner points mentioned in lines 1 and 2 above were in conformance with regulations and rules therefore as required in the current manual of survey instructions of the United States Department of the Interior, Bureau of Land Management or by a decree of a Court of Law and/or that the corner points mentioned in lines 3, 4 and 5 above were in conformance with the rules of the Michigan Board of Land Surveyors or by a Decree of a Court of Law; established, re-established, monumented, re-monumented, recovered, found as

NOTE: Not more than 4 corners, all in the same town and range, may be recorded on this certificate.

A. Description of original monument and accessories and/or subsequent restoration: ORIGINAL G.L.O. SURVEYOR: FLETCHER - MAY 27, 1817.

NANKIN TOWNSHIP

DESCRIPTION OF POST SET FOR CORNER MONUMENT NOT STATED IN FIELD NOTES.

WITNESSES LISTED: BEECH 12 N87E 18 (11.9') (GONE) & HICKORY 10 N27W 12(7.9') (GONE) G.L.O. NOTES - T3S, R9E: "FELL 1.85 (122.10') WEST OF POST COR SEC 35, 36 T2S, R9E"

W.P.A.-(1930'S) SW-36 IRON. WITNESSES SHOWN:ED POLE 54.00'(GONE)

56.00'(GONE) IRON WEST 121.53'(MEAS=121.70')

20" MAPLE SW 85.50'(GONE) 15" MAPLE NW 107.05'(GONE)

R.C.#534 L.19815, P.689 (7-27-77)

expressed below:

B. Description of corner evidence found and/or method applied in restoring or reestablishing corner:

FOUND 1/2" STEEL BAR IN CONC MON/MON BOX IN VAN BORN/MIDDLEBELT RDS. (CONC PVT.)

MEASURED DISTANCES FOR COMPARISON TO W.P.A. RECORDS:

K-13/K-12 W.P.A. = 2646.65 MEAS. = 2647.09

K-13/L-13 W.P.A. = 2639.95 MEAS. = 2639.86

K-12/K-13/L-13 W.P.A. = 90° 03' 20" $MEAS. = 90^{\circ} 03' 28"$

R.C.# 534, L19815, P689 (7-27-77)

K-12 IRON ROD IN MONUMENT IN HAND HOLE. NORTH 2647.04' (MEAS=2647.08')

SPIKE & WCRC WASHER IN POWER POLE. 60.65' (MEAS=60.82') N12°E

PK NAIL IN POWER POLE. N52°E 58.54' (GONE)

SPIKE & WCRC WASHER IN POWER POLE. S10°E 51.30' (MEAS=51.19')

C. Description of monument for corner and accessories established to perpetuate locating the position of the corner; K-13: SECTION CORNER 35&36 T2S R9E, FOUND 1/2" STEEL BAR IN CONC MON/MON BOX. THE SELECTED LOCATION IS ACCEPTED BY THE CONTRACTOR AND IS GENERALLY ACCEPTED BY PROFESSIONAL SURVEYORS AS THE BEST AVAILABLE EVIDENCE OF THE POSITION OF THE ORIGINAL CORNER. PLACED W.C.REMON. BRASS MARKER AND CAP "PPP PS 30096".

FOUND WCRC NAIL/TAG NORTHWEST FACE OF UTILITY POLE. N12°E 60.82' SET NAIL/WCR TAG IN SOUTHEAST FACE OF UTILITY POLE. N43°E 65.24' FOUND WCRC NAIL/TAG SOUTHWEST FACE OF UTILITY POLE. S10°E 51.19' SET NAIL/WCR TAG IN NORTHWEST FACE OF UTILITY POLE. S68°W 166.64 FOUND CONCRETE MONUMENT MONUMENT BOX. WEST 121.70'

SET NAIL/WCR TAG IN NORTHEAST FACE OF UTILITY POLE.

N53°W 82.88

220EC9 Date

30096 Surveyor's Michigan License No. .

FORM APPROVED BY MICHIGAN STATE BOARD OF LAND SURVEYORS, JAN. 28, 1971