

**SURVEY & REMONUMENTATION**

**RC 1133**

DEC 02 1993

**LI 26985 PA 924**

**COMMISSION**

**LAND CORNER RECORDATION CERTIFICATE  
Filing Requirement of Act 74, Mich. P.A. 1970**

For corners in

WAYNE

(County)

Located In:

Corner Code: #

- |                                       |                         |            |
|---------------------------------------|-------------------------|------------|
| 1. Public Land Survey                 | T <u>2S</u> R <u>9E</u> | <u>L-3</u> |
|                                       | T _____ R _____         | _____      |
|                                       | T _____ R _____         | _____      |
|                                       | T _____ R _____         | _____      |
| 2. Property Controlling in Section    | S _____ T _____ R _____ | _____      |
|                                       | S _____ T _____ R _____ | _____      |
| 3. Miscellaneous Property in Sec.     | S _____ T _____ R _____ | _____      |
|                                       | S _____ T _____ R _____ | _____      |
| 4. Lot No. _____, Recorded Plat _____ |                         |            |
| 5. Private Claims _____               |                         |            |

Compliance with ACT 345, P.A. 1990

APPROVED ON: 11/24/93 YCD  
WAYNE COUNTY REMONUMENTATION  
PEER GROUP COMMITTEE

Register of Deeds Stamp & File Number

**RC 1133**

I, P.P. Palczynski, in a field survey on 4 October, 19 93, do hereby certify that under requirements of P.A. 74, Michigan P.A. of 1970, the corner points mentioned in lines 1 and 2 above were in conformance with regulations and rules therefore as required in the current manual of survey instructions of the United States Department of the Interior, Bureau of Land Management or by a decree of a Court of Law and/or that the corner points mentioned in lines 3, 4 and 5 above were in conformance with the rules of the Michigan Board of Land Surveyors or by a Decree of a Court of Law; established, re-established, monumented, re-monumented, recovered, found as expressed below:

**NOTE: Not more than 4 corners, all in the same town and range, may be recorded on this certificate.**

| A  | B  | C  | D  | E  | F  | G  | H | I | J | K | L | M |
|----|----|----|----|----|----|----|---|---|---|---|---|---|
| 2  | 6  | 5  | 4  | 3  | 2  | 1  |   |   |   |   |   |   |
| 3  |    |    |    |    |    |    |   |   |   |   |   |   |
| 4  | 7  | 8  | 9  | 10 | 11 | 12 |   |   |   |   |   |   |
| 5  |    |    |    |    |    |    |   |   |   |   |   |   |
| 6  | 18 | 17 | 16 | 15 | 14 | 13 |   |   |   |   |   |   |
| 7  |    |    |    |    |    |    |   |   |   |   |   |   |
| 8  | 19 | 20 | 21 | 22 | 23 | 24 |   |   |   |   |   |   |
| 9  |    |    |    |    |    |    |   |   |   |   |   |   |
| 10 | 30 | 29 | 28 | 27 | 26 | 25 |   |   |   |   |   |   |
| 11 |    |    |    |    |    |    |   |   |   |   |   |   |
| 12 | 31 | 32 | 33 | 34 | 35 | 36 |   |   |   |   |   |   |
| 13 |    |    |    |    |    |    |   |   |   |   |   |   |

A. Description of original monument and accessories and/or subsequent restoration:

**NANKIN TOWNSHIP**

**G.L.O.- (1830'S) DESCRIPTION OF CORNER MONUMENT NOT STATED IN FIELD NOTES.**

WITNESSES LISTED: BEECH 10 S78E 6 (4.0') (GONE) & DO." 9 N60W 17 (11.2') (GONE)

W.P.A.- (1930'S) IRON SET. WITNESSES SHOWN:

|              |    |               |
|--------------|----|---------------|
| E COR HSE    | NE | 81.81' (GONE) |
| ED. GUY POLE | SE | 43.18' (GONE) |
| STORE        | SW | 72.16' (GONE) |
| ED. POLE     | NW | 60.62' (GONE) |

NO SUBSEQUENT L.C.R.C. OR C.S. FORMS AT WAYNE CO. REG. DEEDS

B. Description of corner evidence found and/or method applied in restoring or reestablishing corner:

FOUND 3/4" IRON PIPE IN CONC MON IN MONUMENT BOX AT WARREN / HARRISON ROADS.

MEASURED DISTANCES FOR COMPARISON TO W.P.A. RECORDS:

|          |                   |                  |
|----------|-------------------|------------------|
| L-3/K-3: | W.P.A. = 2625.49' | MEAS. = 2625.61' |
| L-3/M-3: | W.P.A. = 2624.95' | MEAS. = 2624.88' |

WAYNE COUNTY ROAD COMMISSION (2-3-75) : MONUMENT IN BOX.

|         |    |                      |
|---------|----|----------------------|
| 23" ELM | SE | 63.53' (GONE)        |
| 48" OAK | SW | 94.17' (MEAS. 94.19) |
| ED POLE | NW | 47.86' (GONE)        |


C. Description of monument for corner and accessories established to perpetuate locating the position of the corner:

L-3:SECTION CORNER 1 & 12, T2S R9E, FOUND 3/4" IRON PIPE/CONC MON IN MON BOX. THE SELECTED LOCATION IS ACCEPTED BY THE CONTRACTOR AND IS GENERALLY ACCEPTED BY PROFESSIONAL SURVEYORS AS THE BEST AVAILABLE EVIDENCE OF THE POSITION OF THE ORIGINAL CORNER. PLACED W.C.REMON. BRASS MARKER AND CAP "PPP PS 30096".

|  |       |        |
|--|-------|--------|
| SET CUT "X" IN SW BOLT LIGHT POLE BASE.          | N40°E | 59.18' |
| CENTERLINE OF FIRE HYDRANT STEM.                 | S25°E | 75.43' |
| SET NAIL/WCR TAG IN E FACE 40" OAK.              | S15°W | 94.19' |
| CUT "X" IN NW BOLT OF LIGHT POLE BASE.           | S60°W | 85.87' |
| SW CORNER OF HOUSE #28390 CONC BLOCK FOUNDATION. | N20°W | 88.57' |

Signed by [Signature] Date 15 NOVEMBER 1993

Surveyor's Michigan License No. 30096

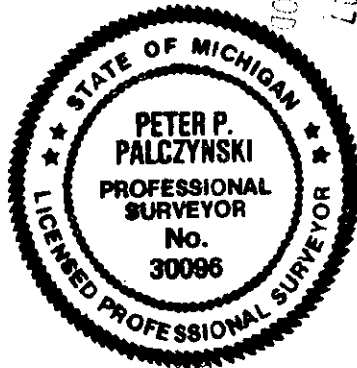

NOV 24 PM 12:07  
FOR SETTING CORNER  
P.P. PALCZYNSKI  
30096

2R  
11KD