

**SURVEY & REMONUMENTATION**

**RC 1470**

**LI27795PA305**

\$ 13.00 MISCELLANEOUS RECORDING  
22 DEC 94 12:05 P.M. RECEIPT# 35B

APR 25 1995

**LAND CORNER RECORDATION CERTIFICATE**

RECORDED  
FOREST E. YOUNGBLOOD, REGISTER OF DEEDS  
WAYNE COUNTY, MI

Filing Requirement of Act 74, Mich. P.A. 1970

For corners in  
**WAYNE**

**COMMISSION**

Located In: Corner Code ##

1. Public Land Survey

T 2S R 9E M-7

T \_\_\_\_\_ R \_\_\_\_\_

T \_\_\_\_\_ R \_\_\_\_\_

T \_\_\_\_\_ R \_\_\_\_\_

2. Property Controlling in Section

S \_\_\_\_\_ T \_\_\_\_\_ R \_\_\_\_\_

S \_\_\_\_\_ T \_\_\_\_\_ R \_\_\_\_\_


3. Miscellaneous Property in Sec.

S \_\_\_\_\_ T \_\_\_\_\_ R \_\_\_\_\_

S \_\_\_\_\_ T \_\_\_\_\_ R \_\_\_\_\_

4. Lot No. \_\_\_\_\_, Recorded Plat \_\_\_\_\_

5. Private Claims \_\_\_\_\_

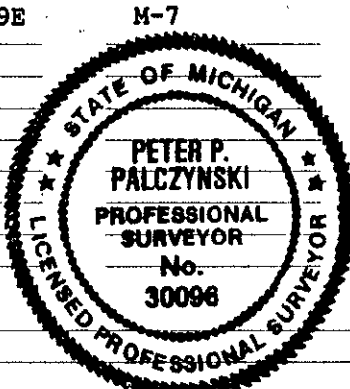

Compliance with  
ACT 345, P.A. 1990

APPROVED ON: 11-21-94  
WAYNE COUNTY REMONUMENTATION  
PEER GROUP COMMITTEE

Register of Deeds Stamp & File Number

**P.P. Palczynski**

7 November

94

I, \_\_\_\_\_, in a field survey on \_\_\_\_\_, 19\_\_\_\_, do hereby certify that under requirements of P.A. 74, Michigan P.A. of 1970, the corner points mentioned in lines 1 and 2 above were in conformance with regulations and rules therefore as required in the current manual of survey instructions of the United States Department of the Interior, Bureau of Land Management or by a decree of a Court of Law and/or that the corner points mentioned in lines 3, 4 and 5 above were in conformance with the rules of the Michigan Board of Land Surveyors or by a Decree of a Court of Law; established, re-established, monumented, re-monumented, recovered, found as expressed below:

**NOTE: Not more than 4 corners, all in the same town and range, may be recorded on this certificate.**

A	B	C	D	E	F	G	H	I	J	K	L	M
2	6	5	4	3	2	1						
3												
4	7	8	9	10	11	12						
5												
6	18	17	16	15	14	13						
7												
8	19	20	21	22	23	24						
9												
10	30	29	28	27	26	25						
11												
12	31	32	33	34	35	36						
13												

**NANKIN TOWNSHIP**

A. Description of original monument and accessories and/or subsequent restoration:

ORIGINAL G.L.O. SURVEYOR: FLETCHER - MAY 27, 1817.

DESCRIPTION OF POST SET FOR CORNER MONUMENT NOT STATED IN FIELD NOTES.

WITNESSES LISTED: SUG 12 N 46 E 10 (6.6') (GONE) & DO. "16 N 1 W 26 (17.2') (GONE)

G.L.O. NOTES - T2S, R10E: "COR SEC 13, 24 T2S, R9E" (NO FALLING NOTED)

W.P.A.-(1930'S) NE-24 IRON. WITNESSES SHOWN: 24" ELM NE 62.98' (GONE)  
ED POLE SW 46.95' (GONE) CROSS-MRKR SE 39.8' (GONE)

W.P.A.-(1930'S) NW-19 IRON. T2S, R10E INDICATE SAME WITNESSES AS ABOVE LISTED.

NO SUBSEQUENT RC OR CS FORMS AT WAYNE COUNTY REGISTER OF DEEDS THIS DATE.

B. Description of corner evidence found and/or method applied in restoring or reestablishing corner:

FOUND 1/2" STEEL BAR IN CONC MON /MON BOX AT INKSTER & CHERRY HILL RDS (CONC PVT)

M-7/M-6:WPA=2641.33'; MEAS=2641.46'; M-7/B-7:WPA=2653.96'; MEAS=2653.88'

M-7/M-8:WPA=2648.44'; MEAS=2648.76'; M-7/L-7:WPA=2697.27'; MEAS=2697.32'

M-6/M-7/B-7:WPA=90°30'10"; MEAS=90°30'29"; B-7/M-7/M-8:WPA=89°13'50"; MEAS=89°13'30"

M-8/M-7/L-7:WPA=89°48'20"; MEAS=89°48'40"; L-7/M-7/M-6:WPA=90°27'10"; MEAS=90°27'21"

C. Description of monument for corner and accessories established to perpetuate locating the position of the corner:

M-7:SECTION CORNER 13 & 24, T2S R9E, FOUND 1/2" STEEL BAR IN CONC MON/MON BOX. THE

SELECTED LOCATION IS ACCEPTED BY THE CONTRACTOR AND IS GENERALLY ACCEPTED BY PROFESSIONAL SURVEYORS AS THE BEST AVAILABLE EVIDENCE OF THE POSITION OF THE ORIGINAL CORNER. PLACED W.C.REMON. BRASS MARKER AND CAP "PPP PS 30096".

SET NAIL/WCR TAG IN EAST FACE UTILITY POLE	N38°E	66.96'
FOUND IRON PIPE AT RIGHT OF WAY	N45°E	84.63'
SET NAIL/WCR TAG IN NORTHEAST FACE UTILITY POLE	S53°E	85.72'
SET NAIL/WCR TAG IN NORTHWEST FACE UTILITY POLE	S40°W	68.93'
FOUND CUT "X" IN NORTHWEST BOLT OF LIGHT POLE BASE	N59°W	75.95'
FOUND IRON PIPE AT RIGHT OF WAY	N45°W	84.55'

2R  
11-D-MIS

Signed by \_\_\_\_\_

Date 22 DEC 94

30096

Surveyor's Michigan License No. \_\_\_\_\_