

**SURVEY &
REMONUMENTATION**

RC 1471

L127795PA306

APR 25 1995

\$ 13.00 MISCELLANEOUS RECORDING
22 DEC 94 12:05 P.M. RECEIPT# 35B
RECORDED
FOREST E. YOUNGBLOOD, REGISTER OF DEEDS
WAYNE COUNTY, MI

COMMISSION

LAND CORNER RECORDATION CERTIFICATE
Filing Requirement of Act 74, Mich. P.A. 1970

For corners in
WAYNE

Located In: Corner Code #

(County)

1. Public Land Survey T 2S R 9E M-9

T _____ R _____

T _____ R _____


T _____ R _____

2. Property Controlling S _____ T _____ R _____
in Section S _____ T _____ R _____

3. Miscellaneous S _____ T _____ R _____
Property in Sec. S _____ T _____ R _____

4. Lot No. _____, Recorded Plat _____

5. Private Claims _____

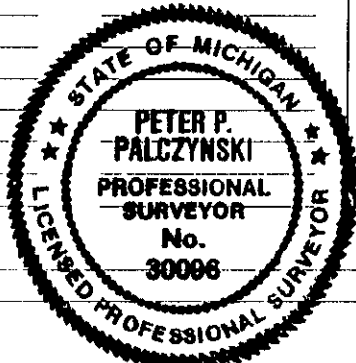

Compliance with
ACT 345, P.A. 1990

APPROVED ON: 11-21-94 [Signature]

WAYNE COUNTY REMONUMENTATION
PEER GROUP COMMITTEE

Register of Deeds Stamp & File Number

P.P. Palczynski 7 November 94

I, _____, in a field survey on _____, 19 _____, do hereby certify that under requirements of P.A. 74, Michigan P.A. of 1970, the corner points mentioned in lines 1 and 2 above were in conformance with regulations and rules therefore as required in the current manual of survey instructions of the United States Department of the Interior, Bureau of Land Management or by a decree of a Court of Law and/or that the corner points mentioned in lines 3, 4 and 5 above were in conformance with the rules of the Michigan Board of Land Surveyors or by a Decree of a Court of Law; established, re-established, monumented, re-monumented, recovered, found as expressed below:

NOTE: Not more than 4 corners, all in the same town and range, may be recorded on this certificate.

	A	B	C	D	E	F	G	H	I	J	K	L	M
2	6		5		4		3		2				
3													
4	7		8		9		10		11		12		
5													
6	18		17		16		15		14		13		
7													
8	19		20		21		22		23		24		
9													
10	30		29		28		27		26		25		
11													
12	31		32		33		34		35		36		
13													

NANKIN TOWNSHIP

A. Description of original monument and accessories and/or subsequent restoration:

ORIGINAL G.L.O. SURVEYOR: FLETCHER - MAY 27, 1817.

DESCRIPTION OF POST SET FOR CORNER MONUMENT NOT STATED IN FIELD NOTES.

WITNESSES LISTED: W ASH 12 N 10 E 31 (6.6') (GONE) & LYNN 12 N 89 W 29 (19.1') (GONE)

G.L.O. NOTES - T2S, R10E, "COR SEC 24, 25, T2S, R9E" (NO FALLING NOTED)

W.P.A.-(1930'S) NE-25 CROSS. WITNESSES SHOWN: NEAR COR LAMP BASE NE 79.50' (GONE)

NEAR COR LAMP BASE NW 107.85' (GONE) NEAR COR LAMP BASE SE 69.15' (GONE)

W.P.A.-(1930'S) NW-30 CROSS. T2S, R10E INDICATE SAME WITNESSES AS ABOVE LISTED.

RC #834, L21996, P846-846.5 (5-3-84)

B. Description of corner evidence found and/or method applied in restoring or reestablishing corner:

FOUND CUT "X" IN WCRB BRASS BENCHMARK DISC IN MON BOX AT INKSTER RD IN BRIDGE

OVER THE ROUGE RIVER. (CONCRETE PAVEMENT)

M-9/M-8:WPA=2647.42'; MEAS=2647.42'; M-9/M-10:WPA=2634.23'; MEAS=2634.03'

M-8/M-9/M-10:WPA=179°45'10"; MEAS=179°45'11"

RC 834 L21996, P846 & 846.5 (5-3-84)

FOUND 1/2" DIAMETER IRON IN MONUMENT BOX.

PK NAIL IN DE POLE WEST SIDE INKSTER ROAD SW 91.17' (MEAS=91.17')

CROSS IN TOP OF BRIDGE WEST SIDE OF INKSTER ROAD SW 36.91' (GONE)

CROSS IN TOP OF BRIDGE EAST SIDE OF INKSTER ROAD SE 59.91' (GONE)

C. Description of monument for corner and accessories established to perpetuate locating the position of the corner:

M-9:SEC COR 24&25, T2S R9E, FD CUT "X" IN WCRB BRASS DISC / MON BOX - INKSTER RD. THE

SELECTED LOCATION IS ACCEPTED BY THE CONTRACTOR AND IS GENERALLY ACCEPTED BY

PROFESSIONAL SURVEYORS AS THE BEST AVAILABLE EVIDENCE OF THE POSITION OF THE

ORIGINAL CORNER. NO W.C.REMON. BRASS MARKER AND CAP "PPP PS 30096" PLACED

FOUND CUT "X" IN CONCRETE BRIDGE RAIL @ NE BRIDGE CORNER N41°E 56.06'

FOUND CUT "X" IN CONCRETE BRIDGE RAIL @ SE BRIDGE CORNER S41°E 56.95'

SET NAIL/WCR TAG IN SOUTHEAST FACE UTILITY POLE S34°W 91.18'

FOUND CUT "X" IN CONCRETE BRIDGE RAIL @ SW BRIDGE CORNER S87°W 35.53'

FOUND CUT "X" IN CONCRETE BRIDGE RAIL @ NW BRIDGE CORNER N23°W 91.60'

FOUND WCRB BRASS BENCHMARK DISC IN WALK OF BRIDGE N21°W 84.71'

2-R
11-0 MIS

Signed by [Signature]

Date 22 DEC 94

Surveyor's Michigan License No. 30096