

RC 1453

LAND CORNER RECORDATION CERTIFICATE

Filing Requirement of Act 74, Mich. P.A. 1970

L127794PA332  
M-01 Page 1

For corners in

Wayne

County

Located in: Romulus Corner Code

ALSO Common TO

1. Public Land Survey

T ~~3~~ S R ~~9~~ E  
T 25 R 9E M-01  
T \_\_\_\_\_ R \_\_\_\_\_ WESTLAND

Compliance with  
ACT 345, P.A. 1990

APPROVED ON: 12/9/94 WCA  
WAYNE COUNTY REMONUMENTATION  
PEER GROUP COMMITTEE

2. Property Controlling  
In Section

S \_\_\_\_\_ T \_\_\_\_\_ R \_\_\_\_\_  
S \_\_\_\_\_ T \_\_\_\_\_ R \_\_\_\_\_

3. Miscellaneous  
Property in Sec.

S \_\_\_\_\_ T \_\_\_\_\_ R \_\_\_\_\_  
S \_\_\_\_\_ T \_\_\_\_\_ R \_\_\_\_\_

Register of Deeds Stamp and File Number

4. Lot No. \_\_\_\_\_, Recorded Plat \_\_\_\_\_  
5. Private Claims \_\_\_\_\_

	A	B	C	D	E	F	G	H	I	J	K	L	M
2	6	5	4	3	2	1							
3													
4	7	8	9	10	11	12							
5													
6	18	17	16	15	14	13							
7													
8	19	20	21	22	23	24							
9													
10	30	29	28	27	26	25							
11													
12	31	32	33	34	35	36							
13													

I, Kenneth S. Wilkerson in a field survey on 11/03/1994  
do hereby certify that under requirements of P.A. 74, Michigan P.A. of 1970, the corner points mentioned in lines 1 and 2 above were in conformance with regulations and rules therefore as required in the current manual of survey instructions of the United States Department of the Interior, Bureau of Land Management. or by a decree of a Court of Law and/or that the corner points mentioned in lines 3, 4 and 5 above were in conformance with the rules of the Michigan Board of Land Surveyors or by a Decree of a Court of Law, established, re-established, monumented, re-monumented, recovered, found as expressed below.

NOTE: Not more than 4 corners, all in the same town and range, may be recorded on this certificate.

A. Description of original monument and accessories and/or subsequent restorations:

01/01/1816 G.L.O. Set post  
20" SYC. N 79 W 13 LINKS (8.58') (GONE)  
9" BEACH N 10 E 20 LINKS (13.20') (GONE)

(Witnesses Continued on Back ...)

B. Description of corner evidence found and/or method applied in restoring or reestablishing corner:

Fd. 1" iron pipe in mon box (no lid) in pvm't @ int. of cl's of Inkster & VanBorn Rds. Dist. to I-13 T2S, R9E = 2637.52' (R), 2637.31' (M). Dist. to A-2 T3S., R10E., = 2641.59'(R), 2641.47'(M).,

C. Description of monument for corner and accessories established to perpetuate locating the position of the corner:


11/03/1994 Wilkerson 21584 O.H.M. Remon  
CORNER COMMON TO 4 TOWNSHIPS.  
S 1/2" I.R. IN 1" I.P. W/ W.C.R. WASHER & CAP ON CORNER.  
8 W.C.R. TAG N.W./S P.P. N 54 E 77.28'  
9 W.C.R. TAG E./S P.P. S 43 W 70.33'  
10 W.C.R. TAG W./S P.P. N 44 W 61.48'  
11 .W. COR. MAIL BOX PAD S43E'  
14 ANGLE TO R. B.S. L-1 = 180-14'26"

\$ 16.00 MISCELLANEOUS RECORDING  
21 DEC 94 3:23 P.M. RECEIPT# 93A  
RECORDED  
FOREST E. YOUNGBLOOD, REGISTER OF DEEDS  
WAYNE COUNTY, MI

We conclude that after careful study of the record documentation and field observations, that this corner is accepted as the best available evidence of the position of the original corner.

Signed by [Signature]  
Drafted by Kenneth S. Wilkerson  
Surveyor's Michigan License No. 21584

Date Dec 9 1994

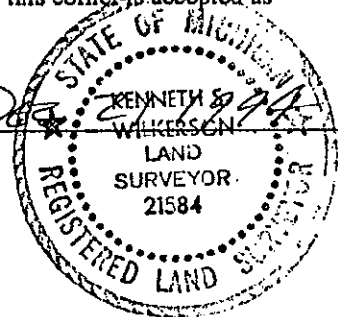

Orchard, Hiltz and McCliment, Inc. 34935 Schoolcraft Road Livonia, MI 48150

ZR  
14 N MISC

## A. (Continued) Description of original monument and accessories and/or subsequent restorations:

01/01/1930

W.C.R.C.

B/T

Fd. iron

- 1 20" MAPLE NE 108.32' (GONE)
- 2 FACE OF SIGN NE 57.20' (GONE)
- 3 D.E. POLE NE 69.90' (GONE)
- 4 CENTERLINE MANHOLE SE 41.95' (GONE)
- 5 D.E. POLE SW 61.30' (GONE)
- 6 D.E. POLE NW 54.52' (GONE)
- 12 DIST TO L-13 T.2S., R.9E., = 2637.52
- 13 DIST TO A-2 T.3S., R.10E., = 2641.59'
- 14 ANGLE TO R B.S.L-1 = 180-28'00"

L127794PA333

01/20/1976

W.C.R.C.

Fd. 3/4" pipe in 3 1/2" conc.

- 7 LITE POLE NE 63.22' (GONE)
- 8 D.E. POLE NE 77.52'
- 9 D.E. POLE SW 70.62'
- 10 LITE POLE NW 61.50'