

FEB 28 1994

COMMISSION LAND CORNER RECORDATION CERTIFICATE

Filing Requirement of Act 74, Mich. P.A. 1970

For corners in

Wayne

(County)

Located In:

Corner Code #

1. Public Land Survey	T	2S	R	10E	B-3
	T		R		
	T		R		
	T		R		
2. Property Controlling in Section	S		T		
	S		T		
3. Miscellaneous Property in Sec.	S		T		
	S		T		

LI 26992 PA 827

Compliance with ACT 345, P.A. 1990

APPROVED ON: 11-30-93 [Signature] WAYNE COUNTY REMONUMENTATION PEER GROUP COMMITTEE

Register of Deeds Stamp & File Number

- 4. Lot No. _____, Recorded Plat _____
- 5. Private Claims _____

A	B	C	D	E	F	G	H	I	J	K	L	M
2	6	5	4	3	2							
3	7	8	9	10	11	12						
4												
5												
6	18	17	16	15	14	13						
7												
8	19	20	21	22	23	24						
9												
10	30	29	28	27	26	25						
11												
12	31	32	33	34	35	36						
13												

Lawrence R.

Feindt

I, Lawrence R. Feindt, in a field survey on October 25, 1993

do hereby certify that under requirements of P.A. 74, Michigan P.A. of 1970, the corner points mentioned in lines 1 and 2 above were in conformance with regulations and rules therefore as required in the current manual of survey instructions of the United States Department of the Interior, Bureau of Land Management or by a decree of a Court of Law and/or that the corner points mentioned in lines 3, 4 and 5 above were in conformance with the rules of the Michigan Board of Land Surveyors or by a Decree of a Court of Law; established, re-established, monumented, re-monumented, recovered, found as expressed below:

NOTE: Not more than 4 corners, all in the same town and range, may be recorded on this certificate.

A. Description of original monument and accessories and/or subsequent restoration:

B-3) 1/4 Corner Common to Sections 6 and 7, T 2 S, R 10 E

GENERAL LAND OFFICE SET POST FOR CORNER

BEECH 12"-N35°W-14 LINKS(9.24')

LYNN 16"-N26°E-26 LINKS(17.16')

DECEMBER 21, 1816

BY: JOSEPH FLETCHER, DS

WAYNE COUNTY BUREAU OF TAXATION

CROSS

S'LY -31.85'-TELEPHONE POLE

NW'LY-48.42'-EDISON POLE

N'LY -50.35'-6"BEECH

FOUND IRON ROD IN HANDHOLE

NW-103.36'-SPIKE WITH BRASS TAG IN NE

SIDE OF 20" ELM

NE- 92.40'-SPIKE WITH BRASS TAG IN SE

SIDE OF 29" ELM

S - 55.00'-"X" CUT IN CONCRETE SIDEWALK

ON S. SIDE OF WARREN AVENUE

AUGUST 7, 1975

BY: RICHARD W. SWANSON, PS #9748


RECORDED IN LIBER 19170, PAGE 21, WCR

WITNESSES BY: WAYNE CO. ROAD COMMISSION 11/27/74

B. Description of corner evidence found and/or method applied in restoring or reestablishing corner:

B-3) 1/4 Corner Common to Sections 6 and 7, T 2 S, R 10 E

Found 1/2" iron pipe in monument box. Distance to A-3 measured 2623.77' (WPA = 2623.86') and distance to C-3 measured 2624.51' (WPA = 2624.98'). Corner was confirmed with irons found in "Valley Park Sub." as recorded in Liber 77 of Plats, Page 75, Wayne County records, and "Warren Valley Sub." as recorded in Liber 74 of Plats, Page 4, Wayne County records.

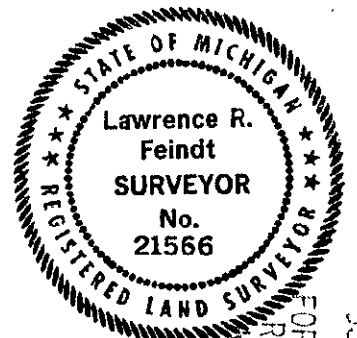

C. Description of monument for corner and accessories established to perpetuate locating the position of the corner:

B-3) 1/4 Corner Common to Sections 6 and 7, T 2 S, R 10 E

Found 1/2" iron pipe in monument box and placed Wayne County brass disk stamped with license #21566 over pipe. Corner is accepted as a careful and faithful reestablishment of the position of the original corner.

- Witnesses:
- N27°W - 58.40' - Top bolt of fire hydrant
 - N78°E - 190.12' - SW bolt of steel light pole #S40DA410
 - S58°E - 76.08' - NW bolt of steel light pole #S40DA420
 - South - 54.93' - Found "X" cut in sidewalk as set by Richard W. Swanson
 - S64°W - 101.74' - Top bolt of fire hydrant

93 NOV 30 AM 11:47 FOREST E. YORK ROAD LIBER 19170 DEEDS WAYNE COUNTY MI

2R 11KJ

Signed by Lawrence R. Feindt

Date November 29, 1993

Surveyor's Michigan License No. 21566