

10001084

FILE DO NOT MAIL

SURVEY & RECORDS

FEB 28 2000

LAND CORNER RECORDATION CERTIFICATE
Filing Requirement of Act 74, Mich. P.A. 1970

CITY OF DEARBORN HEIGHTS
For corners in

Table with columns: WAYNE (County), Located In:, Corner Code #. Rows include Public Land Survey, Property Controlling in Section, and Miscellaneous Property in Sec.

SECTION Page-1
Liber-30855 99593119 12/29/1999
F.E. Youngblood, Wayne Co. Register of Deeds

Compliance with ACT 345, P.A. 1990

APPROVED ON: 12-9-99
WAYNE COUNTY REMONUMENTATION PEER GROUP COMMITTEE

Register of Deeds Stamp & File Number

4. Lot No. , Recorded Plat
5. Private Claims

I, LAWRENCE R. FEINDT, in a field survey on December 2, 1999 do hereby state that under requirements of P.A. 74, Michigan P.A. of 1970, the corner points mentioned in lines 1 and 2 above were in conformance with regulations and rules therefore as required in the current manual of survey instructions of the United States Department of the Interior, Bureau of Land Management or by a decree of a Court of Law and /or that the corner points mentioned in lines 3, 4 and 5 above were in conformance with the rules of the Michigan Board of Land Surveyors or by a Decree of a Court of Law; established, re-established, monumented, recovered, found as expressed below:

Grid table with columns A-M and rows 1-13. A dot is marked at row 5, column B.

NOTE: Not more than 2 corners, all in the same town and range, may be recorded on this certificate.

A. Description of original monument and accessories and/or subsequent restoration:

B-5 CORNER COMMON TO SECTIONS 7 & 18 T2S-R10E

GENERAL LAND OFFICE Set 1/4 Sec. corner Beech 12" S68°E 13 Lks (8.58') Beech 10" S53°W 19 Lks (12.54') December 21, 1816 By: Joseph Fletcher
WAYNE COUNTY BUREAU OF TAXATION Cross SE'ly - 42.80' - Tel Pole (GONE) SW'ly - 13.75' - X in MH Ring (GONE) SW'ly - 41.78' - Iron Drain (GONE) NW'ly - 46.78' - 16" Apple (GONE)
MICH DEPT OF TRANSPORTATION Nov. 8, 1977 By: Ervin P. Miller Mushroom Head Iron in monument box N20°E - 55.59' - Traffic/light pole (GONE) S42°E - 68.95' - Top Fire Hydrant (FOUND) S19°W - 70.65' - Traffic/signal pole (GONE) S21°W - 13.60' - X in MH Rim (GONE) N05°W - 68.57' - PK in Conc. Curb (GONE)

B. Description of corner evidence found and/or method applied in restoring or reestablishing corner:

B-5 CORNER COMMON TO SECTIONS 7 & 18 T2S-R10E

Found 1 1/2" rod in monument box in the center line of Ford Road and John-Daly Road. Corner was confirmed with irons found in "FORD GARDENS ESTATES as recorded in Liber 70 Page 11; comparisons to WPA surveys conducted in the 1930's and one previous witness found.

Distance to corner C-5 Measured 2640.13' (WPA = 2640.04' PLAT = 2640.0')
Distance to corner A-5 Measured 2636.29' (WPA = 2636.00' PLAT = 2636.15')

C. Description of monument for corner and accessories established to perpetuate locating the position of the corner:


B-5 CORNER COMMON TO SECTIONS 7 & 18 T2S-R10E

Found 1 1/2" rod in monument box in concrete pavement at the intersection of Ford Road and John-Daly Road. Corner is accepted as a careful and faithful reestablishment of the position of the original corner.

WITNESSES:

N25°E 79.51' Set chiseled X in SW bolt of light pole base
N41°E 68.99' Top of fire hydrant (R=68.95')
S31°W 77.26' Set chiseled X in NE bolt of light pole base
N42°W 97.49' Set Wayne County Remon disk in NE side 8" pine

Signed by Lawrence R. Feindt

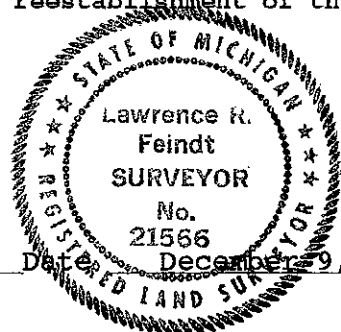

Surveyor's Michigan License No. 21566

R LCR 9 4R 1 Pg A