

FEB 28 1994

COMMISSION

LAND CORNER RECORDATION CERTIFICATE
Filing Requirement of Act 74, Mich. P.A. 1970

LI 25992 PA 829

For corners in

Wayne

(County)

Located In:

Corner Code #

- 1. Public Land Survey T 2S R 10E C-1
2. Property Controlling in Section S T R
3. Miscellaneous Property in Sec. S T R

Compliance with ACT 345, P.A. 1990

APPROVED ON: 11-30-93 DPJ
WAYNE COUNTY REMONUMENTATION PEER GROUP COMMITTEE

Register of Deeds Stamp & File Number

- 4. Lot No. Recorded Plat
5. Private Claims

Grid table with columns A-M and rows 2-13. A circled 'C' is in the top-left corner of the grid.

Lawrence R. Feindt

October 25, 19 93

I, Lawrence R. Feindt, in a field survey on October 25, 19 93, do hereby certify that under requirements of P.A. 74, Michigan P.A. of 1970, the corner points mentioned in lines 1 and 2 above were in conformance with regulations and rules therefore as required in the current manual of survey instructions of the United States Department of the Interior, Bureau of Land Management or by a decree of a Court of Law and/or that the corner points mentioned in lines 3, 4 and 5 above were in conformance with the rules of the Michigan Board of Land Surveyors or by a Decree of a Court of Law; established, re-established, monumented, re-monumented, recovered, found as expressed below:

NOTE: Not more than 4 corners, all in the same town and range, may be recorded on this certificate.

A. Description of original monument and accessories and/or subsequent restoration:

C-1) North corner common to Sections 5 and 6, T 2 S, R 10 E

GENERAL LAND OFFICE
SET POST FOR CORNER
B. ASH 10"-S19 W-16 LINKS (10.56')
B. ASH 9"-S48 E-30 LINKS (19.80')
DECEMBER 22, 1816
BY: JOSEPH FLETCHER, DS


WAYNE COUNTY BUREAU OF TAXATION
IRON ABOUT 1.45' N. OF C/L PAVE'T.
NNE'LY-39.55'-5" ELM
WSW'LY-52.05'-8" OAK
WEST -22.37'-CROSS
WNW'LY-54.25'-CON. POST
WAYNE COUNTY ROAD COMMISSION (IRON)
NE'LY-91.41'-WCR SIGN
SE'LY-84.06'-12" TWIN ELM
SW'LY-69.89'-ED. POLE
NW'LY-77.57'-MARKER

FOUND CONCRETE MONUMENT IN POT
N39 E- 61.40'-PK NAIL SE SIDE OF DE POLE
S41 W- 62.93'-PK NAIL SE SIDE OF DE POLE
S65 E- 67.72'-PK NAIL SW SIDE OF DE POLE
N66 W- 78.12'-PK NAIL SW SIDE OF DE POLE
JANUARY 29, 1979
BY: DANIEL SANDOMIERSKI, PS #24616
RECORDED IN LIBER 20402, PAGE 908, WCR

B. Description of corner evidence found and/or method applied in restoring or reestablishing corner:

C-1) North corner common to Sections 5 and 6, T 2 S, R 10 E

Found concrete monument in monument box. Distance to B-1 measured 2608.25' (WPA = 2608.52') and distance to D-1 measured 2695.52' (WPA = 2695.46').

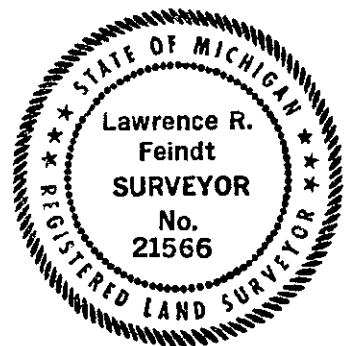

C. Description of monument for corner and accessories established to perpetuate locating the position of the corner:

C-1) North corner common to Sections 5 and 6, T 2 S, R 10 E

Found concrete monument in monument box 9"± deep at the intersection of Joy Road and Beech-Daly Road, and is accepted as a careful and faithful reestablishment of the position of the original corner.

Witnesses: N43 E - 61.42' - Found PK nail in SE face of utility pole and affixed Wayne County brass disk with license #21566
S41 W - 63.02' - Found PK nail with WCRC disk in SE face of utility pole
S53 E - 67.14' - Found PK nail with WCRC disk in SW face of utility pole
N63 W - 78.64' - Found PK nail in SW face of utility pole
West - 22.58' - Found 1/2" iron rod in monument box at South corner common to Sections 31 and 32, T 1 S, R 10 E

93 NOV 30 AM 11:17
FOREST ENGINEERING
REGISTERED SURVEYORS
WAYNE COUNTY MI

Signed by Lawrence R. Feindt Date November 29, 1993

Surveyor's Michigan License No. 21566